

MISSISSIPPI DEPARTMENT OF NATURAL RESOURCES
Bureau of Land and Water Resources
 Southport Mall
 P.O. Box 10631
 Jackson, Mississippi 39209
WATER WELL DRILLERS LOG

10-14-88 19 Layne-Central Company Panola
 date well completed firm name county well located

LANDOWNER:
 Concord-Macedonia Water Assoc
 Rt. 3, Box 107D
 Batesville, MS 38606
 (mailing address)

WELL LOCATION:
 sec 26 T 00 N R 8 E
 S W
 _____ miles _____ of _____
 (distance) (direction) (nearest town)

WELL PURPOSE: UTILITY
 (home, irrigation, municipal, industrial)

WELL COMPLETION DATA:

- (1) diameter (inches) 8"
- (2) total depth (feet) 1254'
- (3) static water level (feet) 177' below top of ground.
- (4) casing Steel 1195'
 (material) (depth)
8" if telescope see back.
 (size)
- (5) screen 51' 1199'
 (length) (depth to top)
4 304SST
 (size) (material)
- (6) pump 25 200
 (HP) (yield gpm)
 Sub. Motor _____
 (type power)
- (7) electric log Yes
 (yes or no)
- Layne-Central-Company
 (organization running log)
- (8) how well bottom plugged Cement

description of formations encountered	from	to
Clay	0	12
Sand & Gravel	12	66
White clay	66	81
Med. Sand & Clay Stks.	81	102
Sandy Clay	102	112
Clay w/soft streaks	112	139
Med. Sand & Clay Streaks	139	175
Sandy Clay & Sand Stks.	175	195
Med. Sand & Clay Stks.	195	242
Rock	242	243
Clay	243	268
Sand & Clay streaks	268	276
Tough Clay	276	285
Rock	285	286
Tough Sandy Shale	286	353
Hard Shale & Sandy Stks	353	509
Sandy shale & Sand Stks	509	572
Med. Sand & Shale Stks.	572	665
Med. Sand, Shale & Lig.	665	697
Sandy shale & Sand Stks	697	713
Hard sandy shale	713	728
Gray clay & Rock stks.	728	802
Hard Clay & Rock Stks.	802	875
Sandy clay & Rock Stks.	875	885
Rock	885	886
Sandy clay & Rock Stks	886	916
Blue sandy Shale	916	947
Blue sandy shale & Sand Streaks	947	978
Fine Sand & Shale Stks.	978	1017
Sandy Shale	1017	1031
Tough Shale	1031	1135
Sandy Shale	1135	1175
Fine Sand, shale, Rock	1175	1261
Lignite	1175	1261
Sandy Shale	1261	1269
Hard Shale & Sandy Stks	1269	1292


DRILLERS REMARKS:
 Department of Natural Resources
 Bureau of Land & Water Resources

APR 28 1989



If well telescopes please sketch and show depths.

GROUND LEVEL

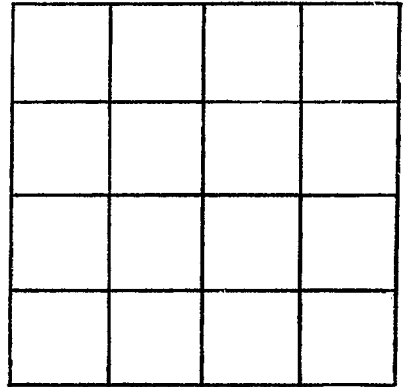

SECTION _____

Please indicate well location X.

ADDITIONAL INFORMATION

If more than one screen,
show locations of each on sketch.