

MISSISSIPPI DEPARTMENT OF ENVIRONMENTAL QUALITY
Office of Land and Water Resources

P. O. Box 10631
Jackson, MS 39289-0631
WATER WELL DRILLERS LOG

COUNTY WELL LOCATED
Panola

WELL NUMBER 2 CODED

L-34

DATE WELL COMPLETED
8-8-2002

PERMIT NUMBER
MSGW 15737

NAME OF DRILLING FIRM
PARKS + PARKS WELL SERVICE

HOUSTON, MS. 38851

NAME & MAILING ADDRESS OF LANDOWNER
CONCORD - MACEDONIA WATER
P.O. BOX 1762
Batesville, MS 38606

Latitude: _____
Longitude: 342048N / 900056W

WELL LOCATION: SEC 3524 TOWNSHIP 8 N RANGE 8 E

DISTANCE 5 Miles DIRECTION NW of NEAREST TOWN BATESVILLE

OTHER LANDMARK _____

WELL PURPOSE: Home, Irrigation, Municipal, Industrial, Fish Pond, etc.
WATER ASSN

PUMP DATA

PUMP TYPE (Circle One):
 Submersible Turbine, Jet, Flowing Well,
Other (Describe) _____

POWER TYPE (Circle One):
 Electric Tractor, Diesel, Gasoline, Butane,
Other (Describe) _____ H/P 25

DESCRIPTION OF FORMATIONS ENCOUNTERED	FROM	TO
GRAVEL	0	90
SAND	90	245
SANDY CLAY	245	330
SAND	330	345
SANDY CLAY	345	400
SAND	400	440
SAND + SHELL	440	480
SAND	480	520
CLAY	520	520
SAND	520	535
CLAY	535	540
SAND	540	680
CLAY	680	860
SAND + CLAY	860	960
SAND	960	980
CLAY	980	1080
SAND	1080	1235
CLAY	1235	1245

WELL DATA

Well Depth 1195 Casing Diameter (In.) 10 3/4 Casing Length (Ft.) 1130

Type of Casing STEEL Hole Depth 1251 Depth to Static Water Level 213

TYPE OF COMPLETION: (Circle One or More):
 Gravel Packed, Underreamed, Telescoped,
 Natural Development, Open Hole, Other
(Describe) _____

WELL GROUTED TO A DEPTH OF 1130 FEET
Type Grout (circle one): Cement Bentonite, or Mix

SCREEN DATA

Diameter - Inches 6 Length - Feet 60 Slot Size - Inches .016

Screen Type S.S. Depth to Bottom - Feet 1195

OCT 17 2002

Top of Lap Pipe or Reduction in Casing
1035 FEET


IF TELESCOPED OR MORE THAN ONE SCREEN: USE BACK PAGE

I certify that the well was drilled, constructed and completed in accordance with all applicable Requirements of the Mississippi Department of Environmental Quality and/or the Mississippi Department of Health regulations and state laws.

Rayburn Parks 0414
Signature of Licensed Driller and License No.

10-8-2002
Date

If well telescopes please sketch and show depths.

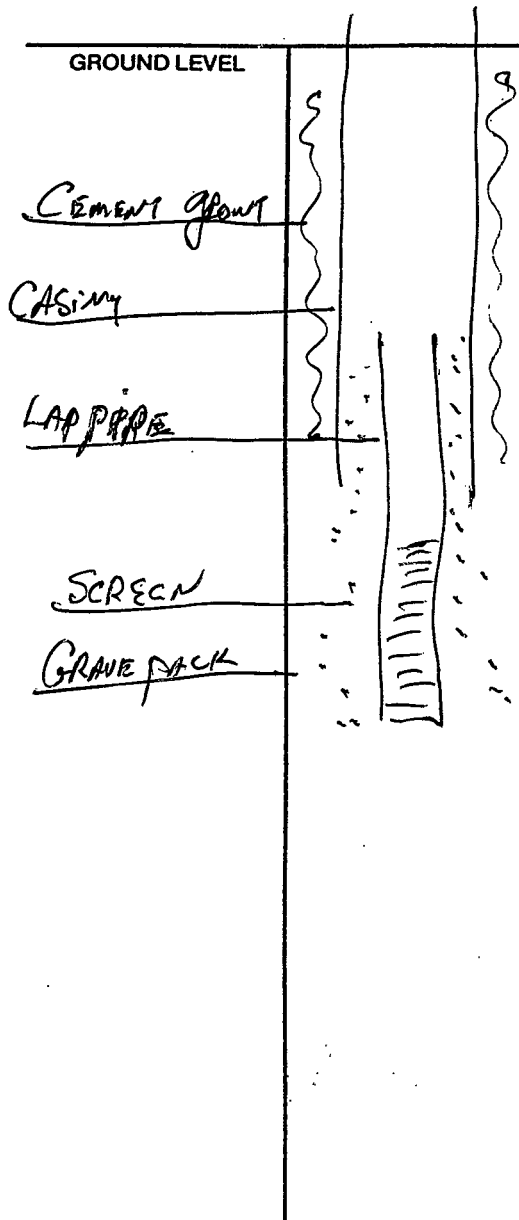

If more than one screen, show location of each on sketch.

SECTION _____

Please indicate well location X.

Pump Capacity (GPM)	No. of Stages	Setting Depth
200	8	273 FT.

PUMP TEST

Well yielded 201 GPM with
 a drawdown of 11 ft.
 after 25 hours of pumping

LOG DATA

TYPE OF LOG RUN (Circle One): No Log Run, Electric, Gamma Ray, Density, Sonic, Neutron, Other (Describe) MSGS

Name of Organization Running Log

MSGS

GEOLOGIC DATA (Office Use Only)

Surface Elev.	Geologic Unit	Unit Thickness	Depth to Top
Subs. SWL	Date	Analysis	Aquifer Test

Driller's Remarks
