

PANOLA  
 L 2000  
 1/27/78

MISSISSIPPI  
 BOARD OF WATER COMMISSIONERS  
 416 North State Street  
 Jackson, Mississippi 39201

WATER WELL DRILLERS LOG

Jan 27 78 19 North Miss Well Drilling Panola  
 date well completed firm name county well located

LANDOWNER: Cha Johnson  
At 3 Batesville  
Miss  
 (mailing address)

description of formations encountered	from	to
Sand & Clay	0	20
Gravel	20	50

WELL LOCATION:  
 sec. 35 T 8 N R 8 E  
4 miles W of Batesville  
 (distance) (direction) (nearest town)

Sand	50	160
------	----	-----

WELL PURPOSE: HOME  
 (home, irrigation, municipal, industrial)

WELL COMPLETION DATA:  
 (1) diameter (inches) 4  
 (2) total depth (feet) 160  
 (3) static water level (feet) 80 <sup>below</sup> <sub>above</sub> top of ground.  
 (4) casing Plastic 160  
 (material) (depth)  
 (size) If telescope see back.  
 (5) screen 10' 160  
 (length) (depth to top)  
4' Plastic  
 (size) (material)  
 (6) pump 1/2 10  
 (HP) (yield gpm)  
Elect  
 (type power)  
 (7) electric log \_\_\_\_\_  
 (yes or no)  
 \_\_\_\_\_  
 (organization running log)  
 (8) how well bottom plugged Plsq


DRILLERS REMARKS:

RECEIVED  
 FEB 27 1978

MISS. BD. OF WATER COMMISSIONERS

If well telescopes please sketch and show depths.

GROUND LEVEL

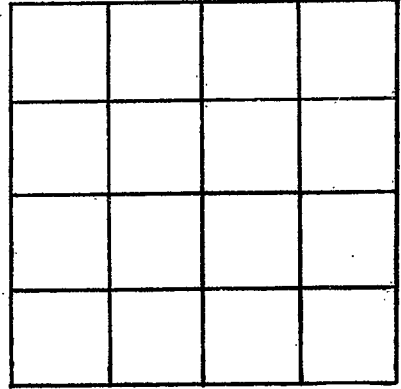

SECTION \_\_\_\_\_

Please indicate well location X.

ADDITIONAL INFORMATION

If more than one screen, show locations of each on sketch.