

Panola  
L 2004  
9-25-81

MISSISSIPPI  
 BOARD OF WATER COMMISSIONERS  
 416 North State Street  
 Jackson, Mississippi 39201

WATER WELL DRILLERS LOG

Sep 25 1981 19 North Miss Water Well Panola  
 date well completed firm name county well located

LANDOWNER: <u>Ever L. Fandren</u> <u>Rt 5 Batesville MS</u> <u>38606</u> (mailing address)	description of formations encountered	from	to
	<u>Red Clay</u>	<u>0</u>	<u>18</u>
	<u>Gravel</u>	<u>18</u>	<u>24</u>
WELL LOCATION: sec <u>23</u> T <u>8</u> N R <u>8</u> E SE SW <u>6</u> miles <u>N-W</u> of <u>Batesville</u> (distance) (direction) (nearest town)	<u>Stickey Clay</u>	<u>24</u>	<u>140</u>
	<u>Sand</u>	<u>140</u>	<u>162</u>
WELL PURPOSE: ( <u>home</u> ) irrigation, municipal, industrial)			
WELL COMPLETION DATA: (1) diameter (inches) <u>4</u> (2) total depth (feet) <u>162</u> (3) static water level (feet) <u>81</u> <u>below</u> above top of ground. (4) casing <u>Pvc</u> , <u>162</u> , (material) (depth) (size) if telescope see back. (5) screen <u>10'</u> , <u>15-2</u> (length) (depth to top) <u>4"</u> , <u>Pvc</u> (size) (material) (6) pump <u>3/4</u> , <u>10</u> (HP) (yield gpm) <u>Elect</u> (type power) (7) electric log <u>yes</u> or <u>no</u> (organization running log) (8) how well bottom plugged <u>Wash Bottle Valve</u>			

DEPT. OF NATURAL RESOURCES  
 BUREAU OF LAND & WATER RESOURCES


OCT 12 1981

RECEIVED

DRILLERS REMARKS:  
Driller Austin Cain  
Po Box 303 Batesville MS  
FHA Well

If well telescopes please  
sketch and show depths.

GROUND LEVEL

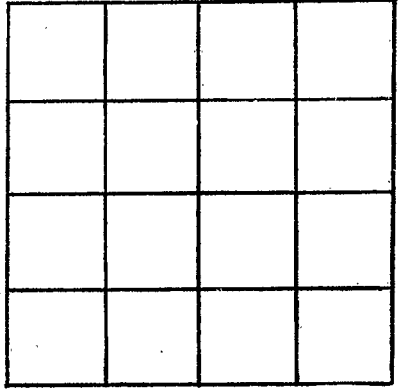

SECTION \_\_\_\_\_

Please indicate well location X.

ADDITIONAL INFORMATION


If more than one screen,  
show locations of each on sketch.