

**MISSISSIPPI
BOARD OF WATER COMMISSIONERS**
416 North State Street
Jackson, Mississippi 39201

WATER WELL DRILLERS LOG

6-24-82
date well completed

19 Austin Cain Well Ser
firm name

Panola
county well located

LANDOWNER Jimmy Singy
Rt 3
Batesville Ms
(mailing address)

description of formations encountered	from	to
Clay	0	25'
Gravel	25	80
Sticky Clay + Sand	80	120
Water Sand	120	185'

WELL LOCATION:
sec. 23 T 8 N R 8 E
SW WL
4 miles W of Batesville
(distance) (direction) (nearest town)

WELL PURPOSE: FHA Home
(home, irrigation, municipal, industrial)

- WELL COMPLETION DATA:
- (1) diameter (inches) 4"
 - (2) total depth (feet) 185'
 - (3) static water level (feet) 80' ^(below)/_(above) top of ground.
 - (4) casing PVC, 185'
(material) (depth)
(size) If telescope see back.
 - (5) screen 10', 175'
(length) (depth to top)
4' PVC
(size) (material)
 - (6) pump 3/4 HP, 10 (yield gpm)
Elect
(type power)
 - (7) electric log _____
(yes or no)

(organization running log)
 - (8) how well bottom plugged 2" Ballers

DRILLERS REMARKS:


DEPT. OF NATURAL RESOURCES
BUREAU OF LAND & WATER RESOURCES

JUL 19 1982

RECEIVED

If well telescopes please sketch and show depths.

GROUND LEVEL

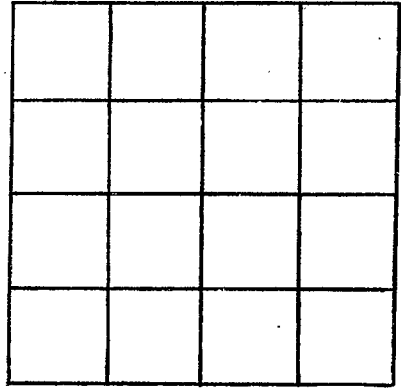

SECTION _____

Please indicate well location X.

ADDITIONAL INFORMATION

If more than one screen, show locations of each on sketch.