

MISSISSIPPI DEPARTMENT OF NATURAL RESOURCES

Bureau of Land and Water Resources

Southport Mall

P.O. Box 10631

Jackson, Mississippi 39209

WATER WELL DRILLERS LOG

Panola
L. 2008

3-8-
date well completed

1983 Austin Cain Well Service
firm name

Panola
county well located

LANDOWNER: Jim Edmon jr
Rt 5 Batesville
MS 38606
(mailing address)

description of formations encountered

from

to

WELL LOCATION:
sec 25 T 8 N S 8 R 8 E W
5 miles N-W of Batesville MS
(distance) (direction) (nearest town)

Clay 0 14
Gravel 14 30
Sand 30 188

WELL PURPOSE:
(home, irrigation, municipal, industrial)

WELL COMPLETION DATA:

- (1) diameter (inches) 4
- (2) total depth (feet) 188
- (3) static water level (feet) 80 below above top of ground.
- (4) casing PVC, 183,
(material) (depth)
4 if telescope see back.
(size)
- (5) screen 10, 193
(length) (depth to top)
4, PVC
(size) (material)
- (6) pump 3/4, 18
(HP) (yield gpm)
Elect
(type power)
- (7) electric log no
(yes or no)

(organization running log)

(8) how well bottom plugged Wash Bottom


DRILLERS REMARKS:

DEPT. OF NATURAL RESOURCES
BUREAU OF LAND & WATER RESOURCES

MAR 16 1983
RECEIVED

If well telescopes please sketch and show depths.

GROUND LEVEL

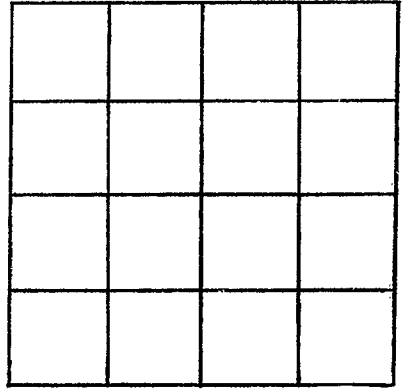

SECTION _____

Please indicate well location X.

ADDITIONAL INFORMATION

If more than one screen,
show locations of each on sketch.