

MISSISSIPPI

BOARD OF WATER COMMISSIONERS

416 North State Street

Jackson, Mississippi 39201

WATER WELL DRILLERS LOG

Parola
L 2009

9-28-84
date well completed

Lips Well
firm name

Parola
county well located

LANDOWNER: George Lamb

description of formations encountered

from to

(mailing address)

WELL LOCATION:

sec. 12 T 8 N R 8 E
9 miles NW of Benedict
(distance) (direction) (nearest town)

clay 0 15
S And 15 100
clay & sand 100 120
S And 120 145

WELL PURPOSE: Home
(home, irrigation, municipal, industrial)

WELL COMPLETION DATA:

- (1) diameter (inches) 4
- (2) total depth (feet) 145
- (3) static water level (feet) 60 below above top of ground.
- (4) casing PVC, 135'
(material) (depth)
4" If telescope see back.
(size)
- (5) screen 10', 135'
(length) (depth to top)
4", PVC
(size) (material)
- (6) pump 1/2, 10
(HP) (yield gpm)
elec
(type power)
- (7) electric log no
(yes or no)

(organization running log)

(8) how well bottom plugged cap

DRILLERS REMARKS:


DEPT. OF NATURAL RESOURCES
BUREAU OF LAND & WATER RESOURCES

OCT 16 1984

RECEIVED

If well telescopes please sketch and show depths.

GROUND LEVEL

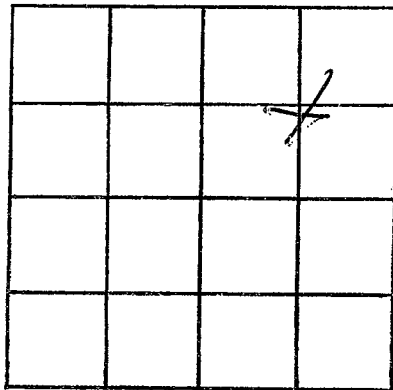

SECTION _____

Please indicate well location X.

ADDITIONAL INFORMATION

If more than one screen, show locations of each on sketch.