

MISSISSIPPI DEPARTMENT OF NATURAL RESOURCES

Bureau of Land and Water Resources

Southport Mall

P.O. Box 10631

Jackson, Mississippi 39209

WATER WELL DRILLERS LOG

PANOLA
L 2010

2-11- 1987 LIPE WELL & SUPPLY PANOLA
 date well completed firm name county well located

LANDOWNER: W.S. HAEPER
215 BOOTH ST.
BATESVILLE, MS
 (mailing address)

WELL LOCATION:
 sec. 23 T. 8 N R. 9 E
 S W
6 miles NW of BATESVILLE
 (distance) (direction) (nearest town)

WELL PURPOSE: HOME
 (home, irrigation, municipal, industrial)

- WELL COMPLETION DATA:
- (1) diameter (inches) 4"
 - (2) total depth (feet) 180'
 - (3) static water level (feet) 105' below top of ground.
 - (4) casing PVC, 170,
 (material) (depth)
 (size) if telescope see back.
 - (5) screen 10, 170
 (length) (depth to top)
4", PVC GRAVEL
 (size) (material)
 - (6) pump 3/4, 10
 (HP) (yield gpm)
ELEC. 1/2
 (type power)
 - (7) electric log NO
 (yes or no)
 (organization running log)
 - (8) how well bottom plugged CAP

description of formations encountered	from	to
TOP SOIL	0	10
CLAY W/ RED SAND	10	20
PEA GRAVEL W/ SAND	20	40
PEA GRAVEL W/ SAND	40	60
GRAVEL	60	70
CLAY	70	80
CLAY W/ SAND	80	100
CLAY	100	120
CLAY	120	140
CLAY W/ SAND	140	160
SAND	160	180


RECEIVED
 RECEIVED
 JAN 19 1988

Department of Natural Resources
 Bureau of Land & Water Resources

DRILLERS REMARKS:

If well telescopes please sketch and show depths.

GROUND LEVEL

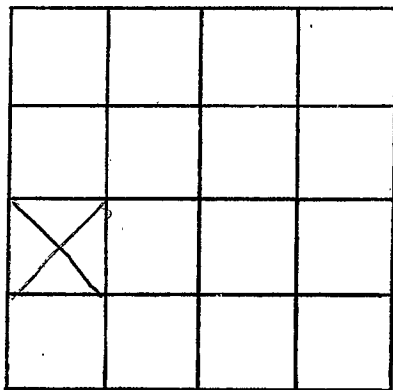

SECTION 23

Please indicate well location X.

ADDITIONAL INFORMATION

If more than one screen,
show locations of each on sketch.