

PANOLA
L 2011

MISSISSIPPI DEPARTMENT OF NATURAL RESOURCES
Bureau of Land and Water Resources
Southport Mall
P.O. Box 10631
Jackson, Mississippi 39209
WATER WELL DRILLERS LOG

Jan. 30 1991 Lipe Well & Supply Co. Inc. PANOLA
date well completed firm name county well located

LANDOWNER: Keith Jenkins
Rt. 2 Box 198
Sardis, Ms. 38666
(mailing address)

WELL LOCATION:
sec. 20 T 8 N R 8 E
9 miles W of Batesville
(distance) (direction) (nearest town)

WELL PURPOSE: Home
(home, irrigation, municipal, industrial)

- WELL COMPLETION DATA:
- (1) diameter (inches) 4"
 - (2) total depth (feet) 200
 - (3) static water level (feet) _____ below above top of ground.
 - (4) casing PVC, 190
(material) (depth)
4" if telescope see back.
(size)
 - (5) screen 10, 190
(length) (depth to top)
4", PVC
(size) (material)
 - (6) pump 1 _____
(HP) (yield gpm)
(type power)
 - (7) electric log (yes or no)
(organization running log)
 - (8) how well bottom plugged Capped

description of formations encountered	from	to
Top soil, clay, gravel	0	20
gravel, clay, gravel	20	40
gravel, clay	40	60
clay with a little sand	60	80
clay with a few streaks sand	80	100
clay at top, sand, clay	100	120
clay at top	120	140
clay	140	160
sand, clay	160	180
sand	150	200

RECEIVED


APR 16 1991

Dept. of Environmental Quality
Bureau of Land & Water Resources

DRILLERS REMARKS:

If well telescopes please
sketch and show depths.

GROUND LEVEL

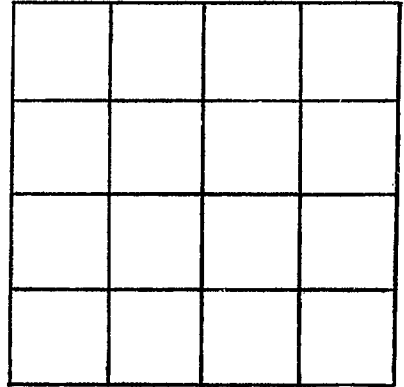

SECTION _____

Please indicate well location X.

ADDITIONAL INFORMATION

If more than one screen,
show locations of each on sketch.