

PANOLA  
L 2/2

MISSISSIPPI DEPARTMENT OF NATURAL RESOURCES  
Bureau of Land and Water Resources  
Southport Mall  
P.O. Box 10631  
Jackson, Mississippi 39209  
WATER WELL DRILLERS LOG

10-8-91 date well completed  
Lipe Wells & Supply firm name  
Panola county well located


LANDOWNER: Pete Partridge  
RTS Box 384  
Batesville, Ms  
(mailing address)

WELL LOCATION:  
sec. 21 T 8 N R 8 E  
6 miles NW of Batesville  
(distance) (direction) (nearest town)

WELL PURPOSE:  
(home, irrigation, municipal, industrial)

WELL COMPLETION DATA:  
(1) diameter (inches) 4"  
(2) total depth (feet) 200  
(3) static water level (feet) 137 below above top of ground.  
(4) casing 4" (material) (depth)  
4" (size) if telescope see back.  
(5) screen 8' 192' (length) (depth to top)  
4" (size) PVC (material)  
(6) pump 1 (HP) 10 (yield gpm)  
ella (type power)  
(7) electric log \_\_\_\_\_  
(yes or no)  
(organization running log)  
(8) how well bottom plugged PVC  
cap

description of formations encountered	from	to
Top Soil	0	17
Gravel	17	20
"	20	40
"	40	60
"	60	63
Clay	63	80
Sand & clay mixed	80	100
"	100	120
"	120	140
"	140	160
Sand and Clay streaks	160	180
Sand and clay	180	200
Sand (soft)	200	210

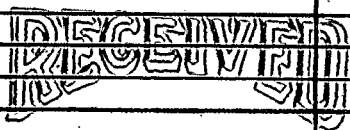


Dept. of Environmental Quality  
Bureau of Land & Water Resources

DRILLERS REMARKS:

If well telescopes please sketch and show depths.

GROUND LEVEL

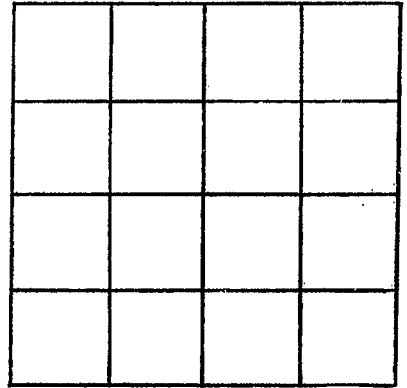

SECTION \_\_\_\_\_

Please indicate well location X.

ADDITIONAL INFORMATION

If more than one screen,  
show locations of each on sketch.