

PANOLA
M

WATER WELL DRILLERS LOG

Date: 10-12-62, 1962, Driller: J B Cain County Panola

(Name)

(1) Owner of Land:	Description & Color of Materials Sand, Clay, Red Clay, Shell, etc.	Thick- ness Feet	Depth Feet
<u>Ernest D. Hill Sr</u> <small>(Name)</small> <u>Route Gordon Mills</u> <small>(Address)</small>	<u>Clay</u> <u>Gravel</u> <u>sand</u>	<u>0</u> <u>40</u> <u>90</u> <u>160</u>	<u>40</u> <u>90</u> <u>160</u>
(2) Location: <u>1/4</u> , <u>1/4</u> , Sec. <u> </u> T <u> </u> R <u> </u>			
<u>5</u> miles <u>north</u> of <u>Batesville</u> <small>(distance) (direction) (Nearest Town)</small>			
(3) Topography: <input checked="" type="checkbox"/> (Hilly) <input type="checkbox"/> (Flat) <input type="checkbox"/> (Level)			
(4) Purpose of Well: <u>Home</u> <small>(Domestic Irrigation Municipal, Industrial, Other)</small>			


Information upon completion of well:

- (1) Diameter 2 inches.
- (2) Total Depth 160 feet.
- (3) Water Level 100 feet below top of ground.
- (4) Cased to 160, Size 2"
- (5) Screen: Size 2, Length 5 FT
- (6) Were any formations sealed against pollution?
 yes, no.

If YES depth of formation _____

Why _____

Drillers Remarks: _____

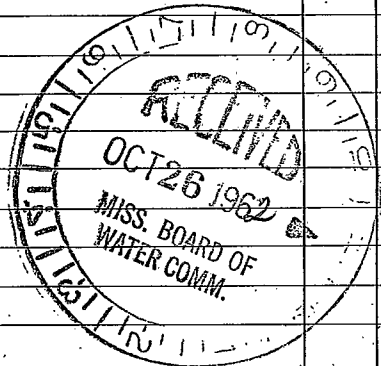

(Use Back Side)

Well No.

