

~~FD-11A~~ *Panola*

M
11-5-62

WATER WELL DRILLERS LOG

Date: 11-5, 1962, Driller: J B Cain County Panola
(Name)


	Description & Color of Materials Sand, Clay, Red Clay, Shell, etc.	Thick- ness Feet	Depth Feet
(1) Owner of Land: <u>Howard Bridges</u> (Name) <u>Lenaada Miss</u> (Address)	<u>Red Clay</u> <u>Sand & shell</u> <u>water sand</u>	<u>0</u> <u>30</u> <u>100</u>	<u>30</u> <u>100</u> <u>130</u>
(2) Location: <u>1/4</u> , <u>1/4</u> , Sec. <u> </u> T. <u> </u> R. <u> </u>			
<u>10</u> miles <u>west</u> , of <u>Scoby</u> (distance) (direction) (Nearest Town)			
(3) Topography: <input checked="" type="checkbox"/> (Hilly) <input type="checkbox"/> (Flat) <input type="checkbox"/> (Level)			
(4) Purpose of Well: <u>Home</u> (Domestic Irrigation Municipal, Industrial, Other)			

Information upon completion of well:

- (1) Diameter 2 inches.
- (2) Total Depth 130 feet.
- (3) Water Level 85 feet below top of ground.
- (4) Cased to 130, Size 2"
- (5) Screen: Size 1/4, Length 6 FT
- (6) Were any formations sealed against pollution?
_____ yes, _____ no.

If YES depth of formation _____
Why _____

Drillers Remarks:
well located, 10 miles west of Scoby on the Tallahatche & Panola County Line

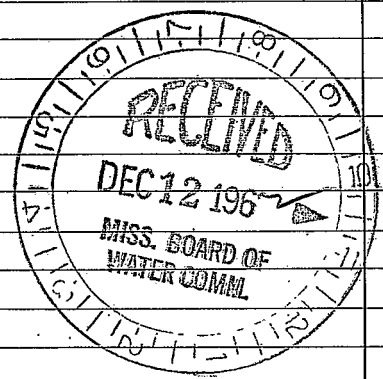

Well No.

10/10/10