

M
7-5-64

WATER WELL DRILLERS LOG

Date: 7-5, 1964, Driller: J B Cain County Panola

(Name)

	Description & Color of Materials Sand, Clay, Red Clay, Shell, etc.	Thick- ness Feet	Depth Feet
(1) Owner of Land: <u>Tate Scott</u> (Name) <u>Batesville Miss</u> (Address)	<u>Brn Clay</u>	<u>0</u>	<u>20</u>
(2) Location: <u>2</u> miles <u>N</u> of <u>Batesville</u> (distance) (direction) (Nearest Town)	<u>Sand</u>	<u>20</u>	<u>60</u>
(3) Topography: <u>Flat</u> (Hilly) (Flat) (Level)	<u>Blue Cl</u>	<u>60</u>	<u>120</u>
(4) Purpose of Well: <u>Bird Farm</u> (Domestic Irrigation Municipal, Industrial, Other)	<u>Band</u>	<u>120</u>	<u>225</u>


Information upon completion of well:

- (1) Diameter 2 inches.
- (2) Total Depth 225 feet.
- (3) Water Level Flow feet below top of ground.
- (4) Cased to 170, Size 2"
- (5) Screen: Size NO, Length NO
- (6) Were any formations sealed against pollution?
_____ yes, _____ no.

If YES depth of formation _____

Why _____

Drillers Remarks: _____

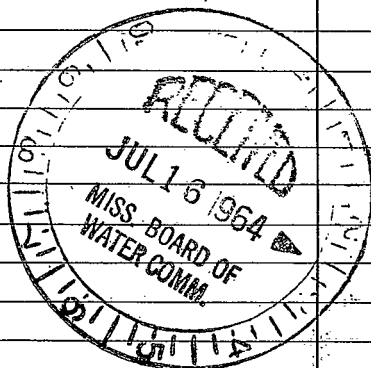

(Use Back Side)

Well No.

