

M

WATER WELL DRILLERS LOG

12-4-65

Date: 12-4, 19 65, Driller: Jimmy Robinson County Panola (Name)

(1) Owner of Land: Mrs. McMillon  
 (Name)  
 Batesville, Miss.  
 (Address)

(2) Location: 1/4, 1/4, Sec. T R  
 6 miles N, of A. Hill  
 (distance) (direction) (Nearest Town)

(3) Topography:  (Hilly)  (Flat)  (Level)

(4) Purpose of Well: Home  
 (Domestic Irrigation  
 Municipal, Industrial, Other)

Description & Color of Materials Sand, Clay, Red Clay, Shell, etc.	Thick- ness Feet	Depth Feet
Clay	0	10
Gravel	10	100
Sand	100	130

Information upon completion of well:

(1) Diameter 4 inches.

(2) Total Depth 130 feet.

(3) Water Level 94 feet below top of ground.

(4) Cased to 120, Size 4 in.


(5) Screen: Size 3 in, Length 10 ft.

(6) Were any formations sealed against pollution?  
 \_\_\_\_\_ yes, \_\_\_\_\_ no.

If YES depth of formation \_\_\_\_\_

Why \_\_\_\_\_

Drillers Remarks: Plastic Well  
 made screen

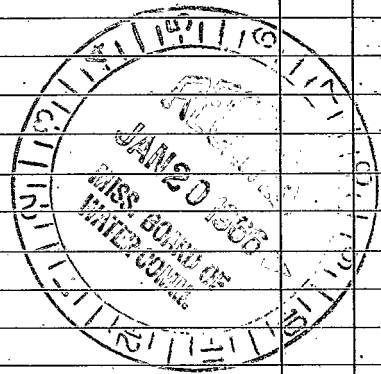

(Use Back Side)

Well No.

