

PANOLA
R M 6

James A. Lipe
WATER WELL DRILLERS LOG **CODED**

Date: 9-10 1964, Driller: Frank Taylor County Panola
(Name)
9-10-64

(1) Owner of Land: James B. Bledsoe
(Name)
Jardis
(Address)

(2) Location: 1/4, 1/4, Sec. 3 T. 8 R. 7
5 miles S. West of Jardis
(distance) (direction) (Nearest Town)

(3) Topography: Hilly
(Hilly) (Flat) (Level)

(4) Purpose of Well: Domestic
(Domestic Irrigation
Municipal, Industrial, Other)

Description & Color of Materials Sand, Clay, Red Clay, Shell, etc.	Thick- ness Feet	Depth Feet
<u>Clay</u>	<u>0</u>	<u>55</u>
<u>Gravel</u>	<u>55</u>	<u>96</u>
<u>Sand</u>	<u>96</u>	<u>146</u>
<u>Up sand</u>	<u>146</u>	<u>184</u>

Information upon completion of well:

(1) Diameter 4 inches.

(2) Total Depth 184 feet.

(3) Water Level 95 feet below top of ground.

(4) Cased to top, Size 4"

(5) Screen: Size 4", Length 4 ft.


(6) Were any formations sealed against pollution?
_____ yes, _____ no.

CODED

If YES depth of formation _____

Why _____

Drillers Remarks: _____

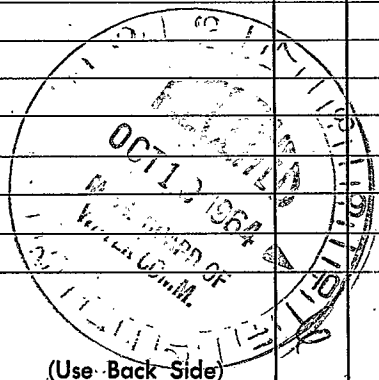

(Use - Back Side)

Well No.

