

PANOLA MISSISSIPPI BOARD OF WATER COMMISSIONERS

Q M 9
3-15-66

James R. Lipe
WATER WELL DRILLERS' LOG

CODED

Date: 3-15, 1966, Driller: Frank Peyton County Panola
(Name)

(1) Owner of Land: J. W. Bailey
(Name)
Sardis
(Address)

(2) Location: 1/4, 1/4, Sec. 8 T8 R7 W1
5 miles S. West of Sardis
(distance) (direction) (Nearest Town)

(3) Topography: Hilly
(Hilly) (Flat) (Level)

(4) Purpose of Well: Domestic
(Domestic Irrigation
Municipal, Industrial, Other)

Description & Color of Materials Sand, Clay, Red Clay, Shell, etc.	Thick- ness Feet	Depth Feet
Clay	0	40
clay & sand	40	60
clay	60	75
sand & gravel	75	100
gravel	100	105
gravel & sand	105	130
sand, red	130	180
sand	180	210
2/3 sand	210	260

Information upon completion of well:

(1) Diameter 4" inches.

(2) Total Depth 260 feet.

(3) Water Level 210 feet below top of ground.

(4) Cased to 254, Size 4"

(5) Screen: Size 1", Length 4'


(6) Were any formations sealed against pollution?
_____ yes, _____ no.

CODED

If YES depth of formation _____

Why _____

Drillers Remarks: _____

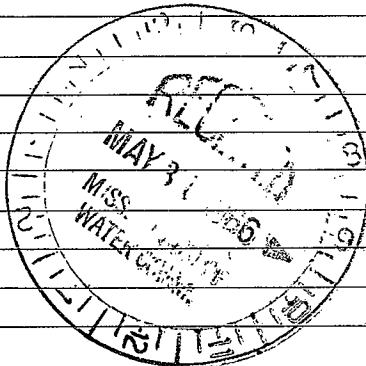

(Use Back Side)

Well No.

100
100
100