

PANOLA
GREENADA

MISSISSIPPI BOARD OF WATER COMMISSIONERS

M 8
5-17-66

James Ray Lyle
WATER WELL DRILLERS LOG

CODED

CODED

Date: 5-17, 1966, Driller: Frank Taylor County Panola
(Name)

(1) Owner of Land: James Bailey
(Name)
Nelson
(Address)

(2) Location: 1/4, 1/4, Sec. 8 T⁸R⁷₃W
5 miles West of Sardis
(distance) (direction) (Nearest Town)

(3) Topography: Level
(Hilly) (Flat) (Level)

(4) Purpose of Well: Domestic
(Domestic Irrigation
Municipal, Industrial, Other)

Description & Color of Materials Sand, Clay, Red. Clay, Shell, etc.	Thick- ness Feet	Depth Feet
Clay	0	80
Clay & sand	80	140
Sand & gravel	140	200
Sand	200	240
W. Sand	240	277

Information upon completion of well:

(1) Diameter 2 inches.

(2) Total Depth 277 feet.

(3) Water Level 225 feet below top of ground.

(4) Cased to 268, Size 2"

(5) Screen: Size 1/4, Length 6"


(6) Were any formations sealed against pollution?
_____ yes, _____ no.

CODED

If YES depth of formation _____

Why _____

Drillers Remarks: _____

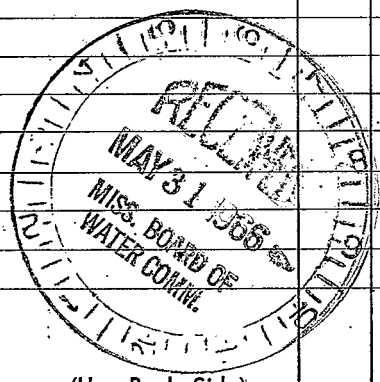

(Use Back Side)

Well No.

62