

Panola
Ms.
12-68

MISSISSIPPI
 BOARD OF WATER COMMISSIONERS
 416 North State Street
 Jackson, Mississippi 39201

CODED

WATER WELL DRILLERS LOG

19 68 JAMES B. LIPE Panola
 date well completed firm name county well located

LANDOWNER: Calvin Johnson
Batesville
Miss.
 (mailing address)

description of formations encountered	from	to
<u>CLAY</u>	<u>0</u>	<u>20</u>
<u>Sand and clay</u>	<u>20</u>	<u>40</u>
<u>Gravel and sand</u>	<u>40</u>	<u>60</u>
<u>" " " "</u>	<u>60</u>	<u>80</u>
<u>SAND</u>	<u>80</u>	<u>105</u>

WELL LOCATION:
 sec 25 T 8 N R 7 E
5 miles NEAST of Batesville
 (distance) (direction) (nearest town)

WELL PURPOSE: home
 (home, irrigation, municipal, industrial)

WELL COMPLETION DATA:

- (1) diameter (inches) 2"
- (2) total depth (feet) 105
- (3) static water level (feet) 60 below above top of ground.
- (4) casing 9814, 99
 (material) (depth)
 (size) if telescope see back.
- (5) screen 6', 99'
 (length) (depth to top)
1/4, S.S.
 (size) (material)
- (6) pump 3/4 rod, 3
 (HP) (yield gpm)
Elec.
 (type power)
- (7) electric log no
 (yes or no)

(organization running log)

(8) how well bottom plugged Paint


DRILLERS REMARKS:

CODED

DEC - 2 1968
 MISS. Bd. OF WATER COM.

If well telescopes please sketch and show depths.

GROUND LEVEL

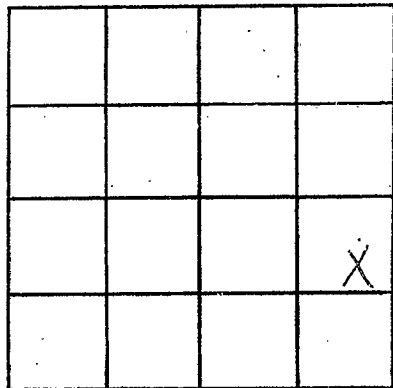

SECTION 25

Please indicate well location X.

ADDITIONAL INFORMATION

If more than one screen,
show locations of each on sketch.