

PANOLA  
M12  
6-8-65

MISSISSIPPI BOARD OF WATER COMMISSIONERS

WATER WELL DRILLERS LOG

**CODED**

Date: 6-8, 1965, Driller: Gerry Roberson County Panola  
(Name)

(1) Owner of Land: James Bolton  
(Name)  
Batesville, Miss  
(Address)

(2) Location:  $\frac{1}{4}$ ,  $\frac{1}{4}$ , Sec. 30 8 7 T R  
  
? miles, of Orville  
(distance) (direction) (Nearest Town)

(3) Topography: ?  
(Hilly) (Flat) (Level)

(4) Purpose of Well: Flame  
(Domestic Irrigation Municipal, Industrial, Other)

Description & Color of Materials Sand, Clay, Red Clay, Shell, etc.	Thick- ness Feet	Depth Feet
<u>Gravel</u>	<u>0</u>	<u>85-</u>
<u>Sand + Clay</u>	<u>85-</u>	<u>130</u>
<u>Sand</u>	<u>130</u>	<u>150</u>

Information upon completion of well:

(1) Diameter 2 inches.

(2) Total Depth 150 feet.

(3) Water Level 110 feet below top of ground.

(4) Cased to 145-, Size 2

(5) Screen: Size 3 in, Length 5 ft


(6) Were any formations sealed against pollution?  
         yes,          no.

**CODED**

If YES depth of formation         

Why         

Drillers Remarks: Plastic well

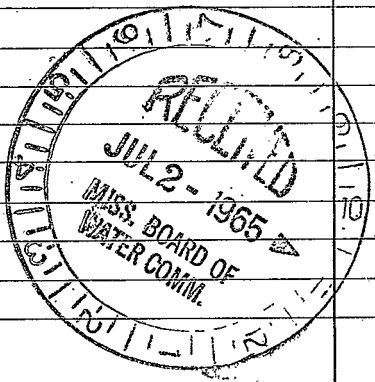

(Use Back Side)

Well No.

