

**PANOLA**  
**MS**  
**3-8-72**

MISSISSIPPI  
 BOARD OF WATER COMMISSIONERS  
 416 North State Street  
 Jackson, Mississippi 39201

**CODED**

**WATER WELL DRILLERS LOG**

MARCH 8, 1972 DEON WHITE PANOLA  
 date well completed firm name county well located

LANDOWNER: ELYENA HARTEE  
 SARDIS, Miss. Rt. 2

description of formations encountered	from	to
Top Soil	0	32
RED & BROWN SAND	32	44
GRAVEL	44	90
FINE WHITE SAND	90	130

(mailing address)

**WELL LOCATION:**

sec. 6 T. 8 N R. 7 E  
 (S) (W)  
 5 1/2 miles SW. of SARDIS  
 (distance) (direction) (nearest town)

WELL PURPOSE: HOME  
 (home, irrigation, municipal, industrial)

**WELL COMPLETION DATA:**

- (1) diameter (inches) 4"
- (2) total depth (feet) 130'
- (3) static water level (feet) 105' below above top of ground.
- (4) casing PLASTIC, 120' (material), (depth)  
 4" (size) if telescope see back.
- (5) screen 10' 130 FT. (length), (depth to top)  
 2" SAND PACKED PLASTIC (size), (material)
- (6) pump 1/2 (HP) 10 (yield gpm)  
 ELE. (type power)
- (7) electric log NO (yes or no)  
 (organization running log)
- (8) how well bottom plugged STRAINER

**CODED**


APR 6 1972

MISS. Bd OF  
 WATER COMMISSIONERS

DRILLERS REMARKS:

If well telescopes please sketch and show depths.

GROUND LEVEL

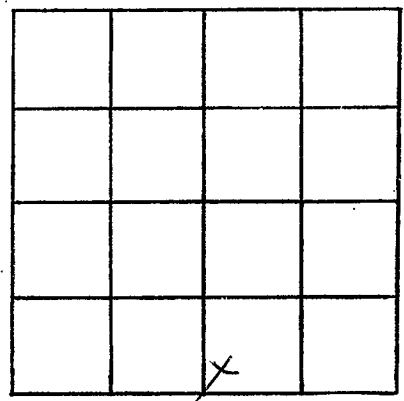

SECTION 6

Please indicate well location X.

ADDITIONAL INFORMATION

If more than one screen, show locations of each on sketch.