

Panola
 MISSISSIPPI
 4-2-74

MISSISSIPPI
 BOARD OF WATER COMMISSIONERS
 416 North State Street
 Jackson, Mississippi 39201
 WATER WELL DRILLERS LOG

APRIL 2 1974 J. LEON WHITE PANOLA
 date well completed firm name county well located

LANDOWNER:
 MR. W. S. DANNER
 SARDIS, Miss. Rt. 2
 (mailing address)

description of formations encountered	from	to
Top Soil	0	30
MIXED SAND & CLAY	30	55
GRAVEL COULE	55	100
WHITE CLAY	100	105
BLUE CLAY	105	210
FINE WHITE SAND	210	245
MED COARSE WHITE SAND	245	265

WELL LOCATION:
 sec. 6 T. 8 N. R. 7 E.
 5 miles S-WS of SARDIS
 (distance) (direction) (nearest town)

WELL PURPOSE: FARM
 (home, irrigation, municipal, industrial)

WELL COMPLETION DATA:

(1) diameter (inches) 4

(2) total depth (feet) 265

(3) static water level (feet) 98' below top of ground.

(4) casing STEEL 105'
 (material) (depth)
 4" (size) if telescope see back.

(5) screen 10' 265'
 (length) (depth to top)
 2" PLASTIC SLOTS
 (size) (material)

(6) pump 3/4 10
 (HP) (yield gpm)
 BLE (type power)

(7) electric log NO
 (yes or no)
 (organization running log)


(8) how well bottom plugged STRAINER

DRILLERS REMARKS:


REC'D
 APR 11 1974

If well telescopes please sketch and show depths.

GROUND LEVEL

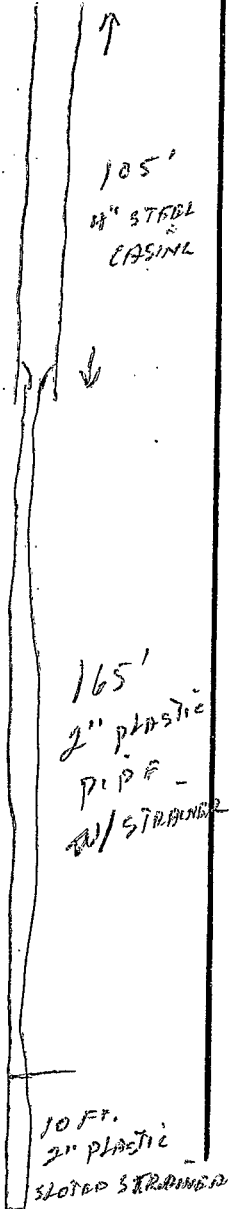

If more than one screen, show locations of each on sketch.

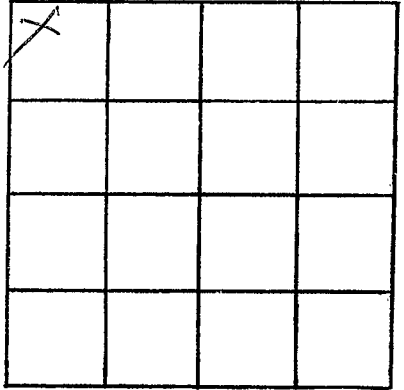

SECTION 6

Please indicate well location X.

ADDITIONAL INFORMATION

Lined area for additional information.