

PANOLA
 M 20
 5-14-74

MISSISSIPPI
 BOARD OF WATER COMMISSIONERS
 416 North State Street
 Jackson, Mississippi 39201

CODED

WATER WELL DRILLERS LOG

5-14

1974 Life Well Co.

Panola

date well completed

firm name

county well located

LANDOWNER:

Viney Creek Church

Sardis Miss.

(mailing address)

description of formations encountered

from

to

Top soil

0 20

red sand

20 40

gravel

40 60

60 80

80 100

white sand

100 120

" "

120 143

WELL LOCATION:

sec. 21 T. 8 N R. 3 E W
 3 miles N. West of Batesville
 (distance) (direction) (nearest town)


WELL PURPOSE: Religious
 (home, irrigation, municipal, industrial)

CODED

WELL COMPLETION DATA:

- (1) diameter (inches) 4
- (2) total depth (feet) 143
- (3) static water level (feet) 60 below top of ground.
- (4) casing PVC, 133 (material), (depth)
 4 (size) if telescope see back.
- (5) screen 10, 133 (length), (depth to top)
 4 (size), PVC (material)
- (6) pump 3/4 (HP), 10 (yield gpm)
 elec. (type power)
- (7) electric log NO (yes or no)
 NO (organization running log)
- (8) how well bottom plugged PVC Plug

DRILLERS REMARKS:

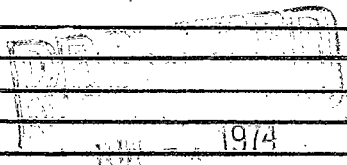

1974

If well telescopes please sketch and show depths.

GROUND LEVEL

			X

SECTION 21

Please indicate well location X.

ADDITIONAL INFORMATION

If more than one screen, show locations of each on sketch.