

PANOLA
M21
12-3-75
Log # 55

MISSISSIPPI
BOARD OF WATER COMMISSIONERS
 416 North State Street
 Jackson, Mississippi 39201

WATER WELL DRILLERS LOG **CODED**

12-3-75 19 Line Well & Supply Co. Panola
 date well completed firm name county well located

LANDOWNER:	description of formations encountered	from	to
Hebrom Water Assoc.			
Sardis, Mississippi (mailing address)	Sand, gravel	80	150
WELL LOCATION:	Sand, coarse	150	210
sec. 16 T. 8 N. R. 7 E S W	Hard gumbo	210	330
5 miles S of Sardis (distance) (direction) (nearest town)	Fine sand	330	370
WELL PURPOSE: Utility (home, irrigation, municipal, industrial)	Sandy shale	370	400
WELL COMPLETION DATA:	Sand, coarse white	400	670
(1) diameter (inches) 8	Hard shale	670	980
(2) total depth (feet) 1110	Fine sand and shale	980	1010
(3) static water level (feet) 160 below top of ground.	Sandy shale	1010	1071
(4) casing Steel 1660 (material) (depth)	Fine sand	1070	1140
8 If telescope see back. (size)			
(5) screen 30 1110 (length) (depth to top)			
6 S.S. (size) (material)			
(6) pump 20 165 gpm @ 70 (HP) (yield-gpm) psi			
elec. (type power)			
(7) electric log yes (yes or no)			
MGS (organization running log)			
(8) how well bottom plugged steel plug			
DRILLERS REMARKS:			


CODED

REGISTERED
MAR 12 1976

MISS. BD. OF WATER COMMISSIONERS

If well telescopes please sketch and show depths.

GROUND LEVEL

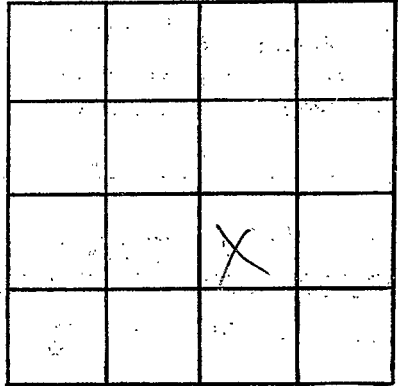

SECTION 16

Please indicate well location X.

ADDITIONAL INFORMATION

If more than one screen, show locations of each on sketch.