

Panel A
M-25
7-25-80
7-25-80

MISSISSIPPI
 BOARD OF WATER COMMISSIONERS
 416 North State Street
 Jackson, Mississippi 39201

WATER WELL DRILLERS LOG

CODED

7-25-80 date well completed 1980 Lipe Well Co. firm name Panel A county well located

LANDOWNER:
Buz Wardlaw
Batesville MS.
 (mailing address)

WELL LOCATION:
 sec. 26 T. 8 N R. 2 E
3 miles East of Batesville
 (distance) (direction) (nearest town)

description of formations encountered	from	to
<u>Top soil</u>	<u>0</u>	<u>20</u>
<u>Coarse sand</u>	<u>20</u>	<u>40</u>
<u>clay</u>	<u>40</u>	<u>50</u>
<u>good sand</u>	<u>50</u>	<u>90</u>

WELL PURPOSE:
 (home, irrigation, municipal, industrial)

- WELL COMPLETION DATA:
- (1) diameter (inches) 4
 - (2) total depth (feet) 140
 - (3) static water level (feet) Flowing below top of ground.
 - (4) casing PVC 126
 (material) (depth)
4 if telescope see back.
 (size)
 - (5) screen 14' 126
 (length) (depth to top)
4 PVC
 (size) (material)
 - (6) pump 3 60
 (HP) (yield gpm)
elec
 (type power)
 - (7) electric log no
 (yes or no)
NON
 (organization running log)
 - (8) how well bottom plugged PVC
cap

CODED


DEPT. OF NATURAL RESOURCES
 BUREAU OF LAND & WATER RESOURCES

AUG 14 1980
 RECEIVED

DRILLERS REMARKS:

If well telescopes please sketch and show depths.

GROUND LEVEL

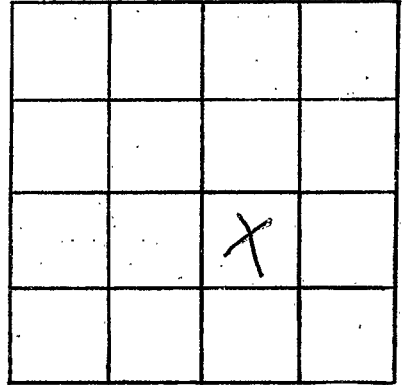

SECTION 26

Please indicate well location X.

ADDITIONAL INFORMATION

If more than one screen,
show locations of each on sketch.