
e `	State U				
De ala	í	ell Report	For Office Use Only:		
County: Panola		Part 1 at of Environmental Quality			
Permit #:	Office of Land	and Water Resources	Aquifer: $M - 36$		
Driller: Willie Bryant	•	Box 10631	Well #: _// - 30		
Date drilling completed: $10 - 6 - 07$	1 · · ·	IS 39289-0631	L. S. Elevation:		
Date drining completed.		961-5210 4-6938 (fax)	E-log #:		
State Law requires that this report be prepared by the driller in detail and filed with the Department within 30 days of completion of drilling of the well.					
Well Owner Informa	Well Owner Information		Location		
Owner Name Henry Melt	<u>n</u>	Latitude: 34. 09.75	<sup>4</sup> Longitude: 090° 28 . 41 "		
Mailing Address: 931 Rock	H:11 Rd.	Hethod of Lat/Long (circle or	Longitude: <u>090° 28 ' 41 "</u> he): Conventional Survey, 2 Y		
	·	USGS quad, Hand-held	GPS, Survey-grade GPS		
<u>Sardis</u> City Sta	5 38666	1/4 1/4 Sec	Twn <u>8</u> S Rng <u>7</u> W		
	-	Distance Direction	Nearest Town		
Telephone No. (662) 487-34	05	32 Miles SW	Nearest Town of <u>Sava's</u>		
(462) 267-851	7	Kock Hill	Rd.		
Well Data					
Purpose of Well (circle one) Home Industrial Public Supply Irrigation Fish Culture Other:					
Date well drilling started: $10 - 6 - 07$ Date well drilling completed: $10 - 6 - 07$					
If flowing, method of flow regulation: Valve Other (describe)					
Static Water Level:feet at	ove or below (circle one)	and surface Date measured:	10-13-07		
		air line other: <b>Ro</b>			
Hole depth: 184 Well de	pth: <u>170</u>	Well grouted to a depth of	10 feet		
Type of grout (circle one): Cement					
Casing length:/60 feet Casing	ng diameter: 4	inches Type of casing:	NC SCH 40		
Screen length: <u>10</u> feet Screen diameter: <u>4</u> inches Type of screen: <u>PVC S/074-ed</u> Screen slot size: <u>0/3</u> inches Setting depth: From <u>160</u> feet to <u>170</u> feet					
Type of completion (circle all applicable): Gravel packed Underreamed Telescoped Open hole Natural Development					
	Other (describe):				
Top of lap pipe or reduction in casing: feet. If telescoped or more than one screen, describe on back of page					
Logs run (circle all applicable): No log run Electric Gamma Ray Density Sonic Neutron Other:					
Name of organization running log(s):					
I certify that the well was drilled, constructed, and completed in accordance with all applicable requirements of the Mississippi					
Department of Environmental Quality and/or the Mississippi Department of Health regulations and state laws.					
Willie L. Bryant	0-0639	Wille	L. Buyant		
Print Name of Water Well Contractor and			Water Well Contractor		

DCT 2 3 2007 BY: OLWR If well telescopes please sketch below and show depths.

Ground Level

Description of Formations Encountered Red Clay & Red Sand Red gravle Clay & Sand fine White Sand Med. White Sand Clay Se white Sand	From 20 40 98 124 144 154	To 20 60 98 124 194 184 184

If more than one screen, show location of each on sketch

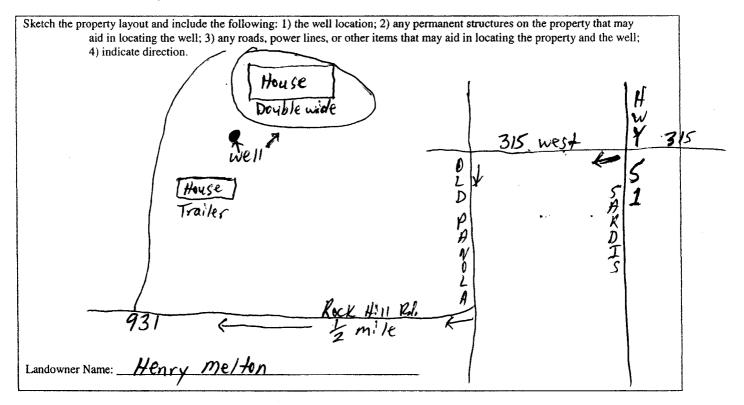

Willie R. Bugart Signature of Water Well Contractor

OCT 2 3 2007 BY: OLWR

M - 36

	STATE W	ELL REPORT	
P I.	Part 2		
County: Panola		's Completion Report For Office Use Only:	
Permit #:		nt of Environmental Quality Aquifer:	
	1	and Water Resources	
Driller: Willie Bryant		Box 10631 MS 39289-0631 Well #: $M - 36$	
		MS 39289-0631 Well #: /// //	
Date completed: <u>10-13-07</u>	1 .	54-6938 (fax) Elevation:	
	[ (001)5.		
This report should be prepared by th installation of pump.	ne pump installer in deta	ail and filed with the Department within 30 days of the	
Well Owner Information	tion	Well Location	
Owner Name: <u>Henry Meltor</u>	<u> </u>	Latitude: 34 09.75 N Longitude: 090 28.41 W	
Mailing Address: 931 Rock Hill Rd.		Method of Lat/Long (circle one): Conventional Survey,	
·		USGS quad, Hand-held GPS, Survey-grade GPS	
<u>Sardi's ms</u> City State	<u>38666</u> Zip Code	<sup>1</sup> / <sub>4</sub> <sup>1</sup> / <sub>4</sub> Sec7 Twn_ <u>85</u> Rng_7 W/	
		Distance Direction Nearest Town	
Telephone No. (662) 487-3405 (662) 267-8517		<u>35</u> Miles <u>SW</u> of <u>Sardis</u> <u>Rock Hill</u> Rd.	
Pump Type	1999 March	Power Type	
Circle one	_	Circle one	
Air Lift Jet	Submersible	Diesel Engine Gasoline Engine Natural Gas	
Bucket Piston	Turbine	Electric Motor Hand Tractor PTO	
Centrifugal Rotary	Flowing Well	Windmill Other (specify):	
Other (specify):		Horse Power Rating of Motor:	
Date Pump Installed: 10-13-07		Setting Depth: <u>120</u> feet	
Rated Pump Capacity:12	_Gallons Per Minute	Number of Stages:	
Pump Test Data		Method of Measuring Water Level	
Date Well Tested: 10-13-07		Circle one	
Static Water Level (A):Feet Below Land Surface		Air Line Electric Measuring Line Steel Tape	
Pumping Water Level (B):Feet Below Land Surface		Other (specify): <u>Rove + weight</u>	
Drawdown [(B) – (A)]:Feet Below Land Surface		For flowing well, measured shut in head:feet	
Test Pumping Rate:	_Gallons Per Minute	Well yielded GPM with a drawdown of	
Duration of Pump Test (minimum 4 hours)	: <u> </u>	feet afterhours of pumping	

I HEREBY CERTIFY that the above statements are true to the best of my knowledge.

Willie L. Bryant 0-0639 Print Name of Pump Installer and License No. (if applicable) Willie L. Bujant Signature of Pumpunstaller

BY: OLWR