

PANOLA  
M 2000  
4-18-76

MISSISSIPPI  
BOARD OF WATER COMMISSIONERS  
416 North State Street  
Jackson, Mississippi 39201

WATER WELL DRILLERS LOG

4-18-76 19 J.B. Cain Panola  
date well completed Big Shavers county well located  
Drill name

LANDOWNER: Jimmy Sales  
Rt 3 Batesville Miss  
(mailing address)  
WELL LOCATION:  
sec 25 T 8 N R 27 E  
4 miles NE of Batesville  
(distance) (direction) (nearest town)

description of formations encountered	from	to
Clay	0	23
Gravel	23	72
Clay	72	95
Sand	95	150

WELL PURPOSE: HOME  
(home, irrigation, municipal, industrial)

WELL COMPLETION DATA:

(1) diameter (inches) 4"

(2) total depth (feet) 150

(3) static water level (feet) 120 below above top of ground.

(4) casing Plastic, 150,  
(material) (depth)  
(size) If telescope see back.

(5) screen 10', 140  
(length) (depth to top)  
4", Plastic  
(size) (material)

(6) pump 3/4 10  
(HP) (yield gpm)  
Elect  
(type power)

(7) electric log NO  
(yes or no)  
(organization running log)


(8) how well bottom plugged Plug

DRILLERS REMARKS:

REGISTERED  
APR 27 1976

If well telescopes please sketch and show depths.

GROUND LEVEL

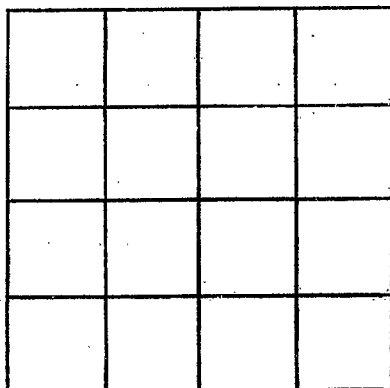

SECTION \_\_\_\_\_

Please indicate well location X.

ADDITIONAL INFORMATION

If more than one screen, show locations of each on sketch.