

OLA  
M 2082  
1/25/77

MISSISSIPPI  
BOARD OF WATER COMMISSIONERS  
416 North State Street  
Jackson, Mississippi 39201

WATER WELL DRILLERS LOG

Jan 25 1977 Lipe Well Co. Panola  
date well completed firm name county well located

LANDOWNER:	description of formations encountered	from	to
Mantha Morris Batesville Ms. (mailing address)			

WELL LOCATION:  
sec. 35 T 8 N R 7 E  
3 miles N. E. of Batesville  
(distance) (direction) (nearest town)

WELL PURPOSE:  
(home, irrigation, municipal, industrial)

- WELL COMPLETION DATA:
- (1) diameter (inches) 4
  - (2) total depth (feet) 64
  - (3) static water level (feet) 10 below above top of ground.
  - (4) casing PVC 64 (material) (depth)  
4 (size) If telescope see back.
  - (5) screen 10 54 (length) (depth to top)  
4 PVC (size) (material)
  - (6) pump 3/4 10 (HP) (yield gpm)  
elec (type power)
  - (7) electric log non (yes or no)  
non (organization running log)
  - (8) how well bottom plugged PVC CAP


DRILLERS REMARKS:

RECEIVED  
FEB 22 1977

MISS. BD. OF WATER COMMISSIONERS

If well telescopes please sketch and show depths.

GROUND LEVEL

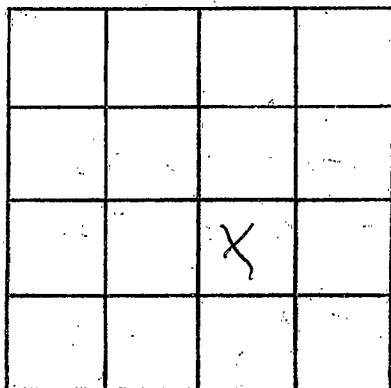

SECTION

35

Please indicate well location X.

ADDITIONAL INFORMATION

If more than one screen, show locations of each on sketch.