

PANOLA
 M 2004
 9-21-77

MISSISSIPPI
 BOARD OF WATER COMMISSIONERS
 416 North State Street
 Jackson, Mississippi 39201

WATER WELL DRILLERS LOG

9-21-77 date well completed
 15F North Miss Well Drilling Panola firm name
 Panola county well located

LANDOWNER: Tom Cooper
Rt 3 Batesville
Miss 38606
 (mailing address)

description of formations encountered	from	to
Clay	0	21
Sand	21	85

WELL LOCATION:
 sec 25 T 8 N. R. 7 E
4 1/2 miles NE of Batesville
 (distance) (direction) (nearest town)

WELL PURPOSE: HOME
 (home, irrigation, municipal, industrial)

WELL COMPLETION DATA:

- (1) diameter (inches) 4
- (2) total depth (feet) 83
- (3) static water level (feet) 50 below top of ground. above
- (4) casing Plastic 85
 (material) (depth)
 (size) If telescope see back.
- (5) screen 5' 80
 (length) (depth to top)
2" Plastic
 (size) (material)
- (6) pump 1/2 10
 (HP) (yield gpm)
Elect
 (type power)
- (7) electric log NO
 (yes or no)

(organization running log)
 (8) how well bottom plugged Plug


DRILLERS REMARKS:

RECEIVED
 SEP 28 1977

MISS. BD. OF WATER (COMM)

If well telescopes please
sketch and show depths.

GROUND LEVEL

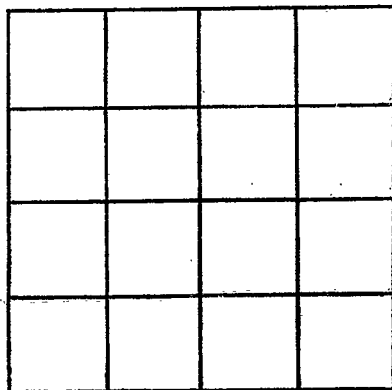

SECTION _____

Please indicate well location X.

ADDITIONAL INFORMATION

If more than one screen,
show locations of each on sketch.