

PANOLA
 M 2005
 1/29/78

MISSISSIPPI
 BOARD OF WATER COMMISSIONERS
 416 North State Street
 Jackson, Mississippi 39201

WATER WELL DRILLERS LOG

1-24 1978 Lipe Well Co. Panola
 date well completed firm name county well located

LANDOWNER:
 G. W. Ramsey
 Sardis MS.
 (mailing address)

description of fomations encountered	from	to
Topsoil	0	20
Gravel	20	40
Sand	40	80

WELL LOCATION:
 sec. 22 T. 8 N. R. 3 E. W. 3
 3 miles north of Batesville
 (distance) (direction) (nearest town)

WELL PURPOSE:
 (home, irrigation, municipal, industrial)

WELL COMPLETION DATA:

(1) diameter (inches) 4

(2) total depth (feet) 80

(3) static water level (feet) 8 above top of ground.

(4) casing PVC 70 (material) (depth)
 4 (size) if telescope see back.

(5) screen 10 70 (length) (depth to top)
 4 PVC (size) (material)

(6) pump 3/4 (HP) (yield gpm)
 (type power)

(7) electric log (yes or no)
 (organization running log)


(8) how well bottom plugged

DRILLERS REMARKS:

RECEIVED
 FEB - 1 1978

If well telescopes please sketch and show depths.

GROUND LEVEL

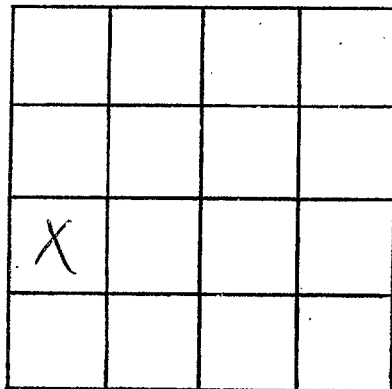

SECTION 92

Please indicate well location X.

ADDITIONAL INFORMATION

If more than one screen,
show locations of each on sketch.