

Panola
M 2006

MISSISSIPPI
BOARD OF WATER COMMISSIONERS
416 North State Street
Jackson, Mississippi 39201

WATER WELL DRILLERS LOG

11-3 19 78 Lipe Well Co. Panola
date well completed firm name county well located


LANDOWNER:
Otis Griffing
Batesville Ms.
(mailing address)

description of formations encountered	from	to
Topsoil	0	20
Gravel	20	30
Clay	30	40
Sand	40	60

WELL LOCATION:
sec. 19 T. 8 N. R. 7 E. S. 3 W. ?
6 miles N. of Batesville
(distance) (direction) (nearest town)

WELL PURPOSE:
(home) irrigation, municipal, industrial

- WELL COMPLETION DATA:
- (1) diameter (inches) 4
 - (2) total depth (feet) 60
 - (3) static water level (feet) 20 below above top of ground.
 - (4) casing PVC 50 (material) (depth)
 - 4 (size) If telescope see back.
 - (5) screen 10 58 (length) (depth to top)
 - 4 PVC (size) (material)
 - (6) pump 3/4 10 (HP) (yield gpm)
 - elec. (type power)
 - (7) electric log NON (yes or no)
 - NON (organization running log)
 - (8) how well bottom plugged PVC CAP

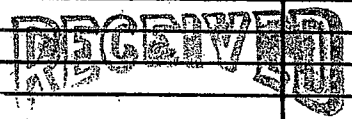


DEC - 4 1978

DRILLERS REMARKS:

If well telescopes please sketch and show depths.

GROUND LEVEL

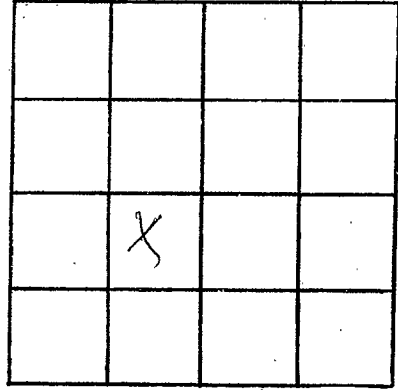

SECTION 19

Please indicate well location X.

ADDITIONAL INFORMATION

If more than one screen, show locations of each on sketch.