

Panola

M 2008

5-20-80

5-20

MISSISSIPPI
 BOARD OF WATER COMMISSIONERS
 416 North State Street
 Jackson, Mississippi 39201

WATER WELL DRILLERS LOG

date well completed 5-20-80 firm name 80 North Miss Well Dr. Panola county well located Panola

LANDOWNER: Robert Douglas

Description of formations encountered	from	to
<u>Clay</u>	<u>0</u>	<u>10</u>
<u>Gravel</u>	<u>10</u>	<u>85</u>
<u>Clay</u>	<u>85</u>	<u>90</u>
<u>Gravel</u>	<u>90</u>	<u>100</u>

(mailing address)

WELL LOCATION:

sec. 16 T. 8 N. R. 7 E.
4 miles N of Baton Rouge
 (distance) (direction) (nearest town)

WELL PURPOSE: Home
 (home, irrigation, municipal, industrial)

WELL COMPLETION DATA:

- (1) diameter (inches) 4"
- (2) total depth (feet) 100
- (3) static water level (feet) 85 below top of ground.
- (4) casing Plastic, 100
 (material) (depth)
- (size) If telescope see back.
- (5) screen 10', 90
 (length) (depth to top)
4", Plastic Slot
 (size) (material)
- (6) pump 1/2, 10
 (HP) (yield gpm)
Elco
 (type power)
- (7) electric log _____
 (yes or no)

(organization running log)

(8) how well bottom plugged Wash Bot

DRILLERS REMARKS:


DEPT. OF NATURAL RESOURCES
 BUREAU OF LAND & WATER RESOURCES

JUN 30 1980

RECEIVED

If well telescopes please sketch and show depths.

GROUND LEVEL

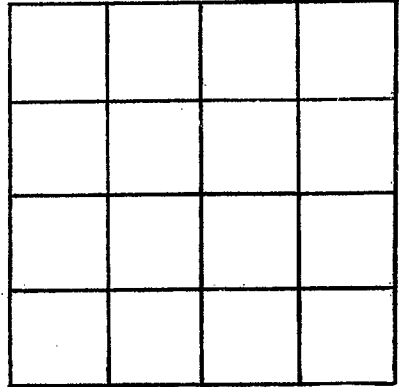

SECTION _____

Please indicate well location X.

ADDITIONAL INFORMATION

If more than one screen, show locations of each on sketch.