

PANOLA  
M 2009  
8-11-80

MISSISSIPPI  
BOARD OF WATER COMMISSIONERS  
416 North State Street  
Jackson, Mississippi 39201

WATER WELL DRILLERS LOG

8-11-1980 date well completed      High Well Co firm name      Panola county well located

LANDOWNER: <u>Tom Taylor</u> <u>Rt 1</u>	description of formations encountered	from	to
<u>Sardis, Ms.</u> (mailing address)	Clay	0	20
WELL LOCATION: sec. <u>1</u> T. <u>8</u> N. R. <u>7</u> E <u>2</u> miles <u>3</u> of <u>Sardis</u> (distance) (direction) (nearest town)	Gravel	20	80
WELL PURPOSE: <u>Home</u> (home, irrigation, municipal, industrial)	White Sand	80	150
WELL COMPLETION DATA:			
(1) diameter (inches) <u>4"</u>			
(2) total depth (feet) <u>150</u>			
(3) static water level (feet) <u>100</u> below top of ground.			
(4) casing <u>PVC</u> , <u>150</u> (material) (depth)			
_____ If telescope see back. (size)			
(5) screen <u>7</u> , <u>143</u> (length) (depth to top)			
_____ <u>4"</u> , <u>gravel type</u> (size) (material)			
(6) pump <u>1/2</u> , <u>10</u> (HP) (yield gpm)			
_____ <u>220V</u> (type power)			
(7) electric log <u>No</u> (yes or no)			
_____ (organization running log)			
(8) how well bottom plugged <u>Cap</u>			
DRILLERS REMARKS:			


DEPT. OF NATURAL RESOURCES  
BUREAU OF LAND & WATER RESOURCES

SEP 26 1980

RECEIVED

If well telescopes please sketch and show depths.

GROUND LEVEL

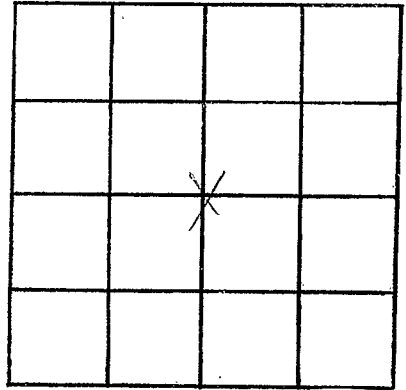

SECTION 1

Please indicate well location X.

ADDITIONAL INFORMATION

If more than one screen, show locations of each on sketch.