

MISSISSIPPI DEPARTMENT OF NATURAL RESOURCES
 Bureau of Land and Water Resources
 Southport Mall
 P.O. Box 10631

Jackson, Mississippi 39209
 WATER WELL DRILLERS LOG

<i>Panola</i>
<i>M</i>
<i>2010</i>

3-29 1982 *HICKS WELL COMPANY* *Panola*
 date well completed firm name county well located

LANDOWNER: *Drew Norris*
Rt. 2 Box 229
Coro, Miss. 38619
 (mailing address)

WELL LOCATION:
 sec. *1* T. *8* N. R. *7* E
2 miles *SE* of *Sardi*
 (distance) (direction) (nearest town)

WELL PURPOSE: *None*
 (home, irrigation, municipal, industrial)

- WELL COMPLETION DATA:
- diameter (inches) *4*
 - total depth (feet) *215*
 - static water level (feet) *160* below above top of ground.
 - casing *PVC*, *215* (material) (depth)
 - screen *12*, *203* (length) (depth to top)
02, *gravel + PVC* (size) (material)
 - pump *1/2*, *10* (HP) (yield gpm)
220V (type power)
 - electric log *No* (yes or no)
 - (organization running log)
 - how well bottom plugged *Cap*

description of formations encountered

from

to

<i>Red Sand</i>	<i>0</i>	<i>50</i>
<i>Gravel</i>	<i>50</i>	<i>110</i>
<i>Yellow clay sand</i>	<i>110</i>	<i>125</i>
<i>White clay</i>	<i>125</i>	<i>180</i>
<i>White sand</i>	<i>180</i>	<i>215</i>

DEPT. OF NATURAL RESOURCES
 BUREAU OF LAND & WATER RESOURCES


APR 13 1982

RECEIVED

DRILLERS REMARKS:

If well telescopes please sketch and show depths.

GROUND LEVEL

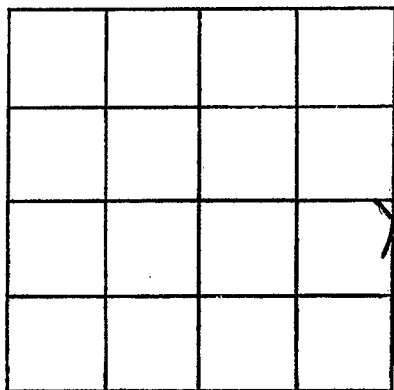

SECTION

Please indicate well location X.

ADDITIONAL INFORMATION

If more than one screen,
show locations of each on sketch.