

MISSISSIPPI DEPARTMENT OF ENVIRONMENTAL QUALITY

QUALITY

Office of Land and Water Resources

P. O. Box 10631

Jackson, MS 39289-0631

WATER WELL DRILLERS LOG

COUNTY WELL LOCATED PAWNEE	
WELL NUMBER M-2022	CODED
DATE WELL COMPLETED 6-19-01	

PERMIT NUMBER 1000000000
NAME OF DRILLING FIRM WELL

NAME & MAILING ADDRESS OF LANDOWNER Andrew Anderson		
7080 Old Pawola Rd.		
Sardis, MS 38666		
WELL LOCATION: SEC	TOWNSHIP	RANGE
5	8	N 7 E
DISTANCE	DIRECTION	NEAREST TOWN
3 Miles	SW	Sardis
OTHER LANDMARK		
WELL PURPOSE: <u>Home Irrigation</u> , Municipal, Industrial, Fish Pond, etc.		

PUMP DATA		
PUMP TYPE (Circle One): <input checked="" type="radio"/> Submersible Turbine Jet Flowing Well, Other (Describe) _____		
POWER TYPE (Circle One): Electric, Tractor, Diesel, Gasoline, Butane, Other (Describe) _____ H/P 3		
Pump Capacity (GPM) 50	No. of Stages	Setting Depth 160 FT.
PUMP TEST		
Well yielded no GPM with a drawdown of Feed ft. after _____ hours of pumping		

WELL DATA		
Well Depth 175	Casing Diameter (In.) 4	Casing Length (Ft.) 155
Type of Casing PVC	Hole Depth 185	Depth to Static Water Level 120
TYPE OF COMPLETION: (Circle One or More): <input checked="" type="checkbox"/> Gravel Packed Underreamed Telescoped, <input checked="" type="checkbox"/> Natural Development, Open Hole, Other		
(Describe) _____		

LOG DATA	
TYPE OF LOG RUN (Circle One): Electric, Gamma Ray, Density, Sonic, <input checked="" type="radio"/> Neutron, Other (Describe) _____	
Name of Organization Running Log	

WELL GROUTED TO A DEPTH OF 3 FEET
Type Grout (circle one): Cement, <u>Bentonite</u> , or Mix

GEOLOGIC DATA (Office Use Only)			
Surface Elev.	Geologic Unit	Unit Thickness	Depth to Top
Subs. SWL	Date	Analysis	Aquifer Test

SCREEN DATA		
Diameter - Inches 4	Length - Feet 30'	Slot Size - Inches .013
Screen Type PVC Slotted	Depth to Bottom - Feet 155	

Driller's Remarks	
Top of Lap Pipe or Reduction in Casing	
FEET	IF TELESCOPED OR MORE THAN ONE SCREEN: USE BACK PAGE

DESCRIPTION OF FORMATIONS ENCOUNTERED	FROM	TO
Brown + White Clay	0	25
Gravel	25	110
White Sand + Clay	110	140
White Sand	140	185

FORMATIONS (Continued)	FROM	TO


REC'D AUG 22 2001

If well telescopes please sketch and show depths.

PAROLA

10-01-01

GROUND LEVEL

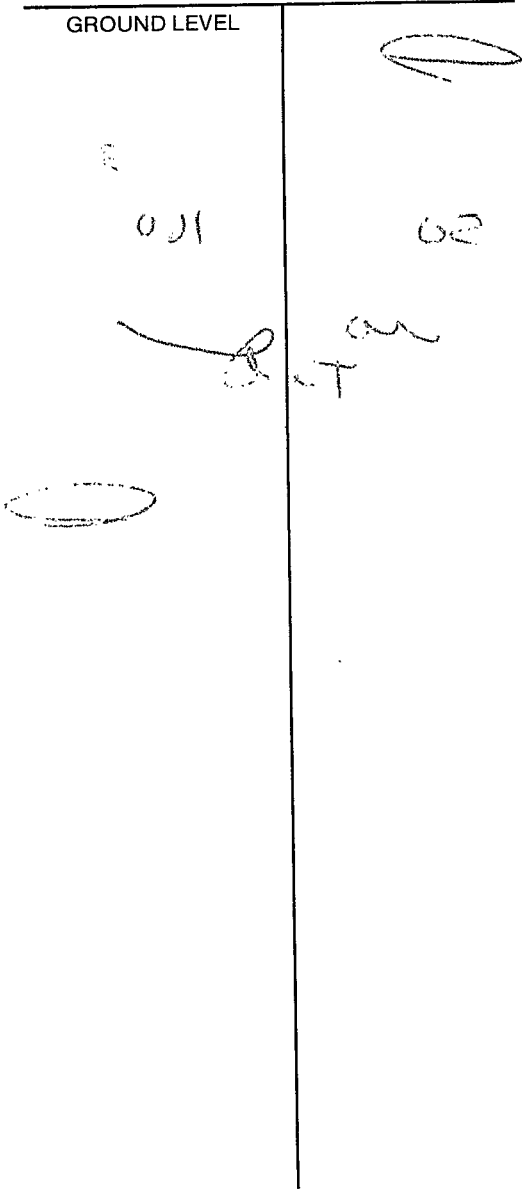

Andrew Anderson	110	0800	
1080 of Andrew Anderson	110	0800	
2000 of Andrew Anderson	110	0800	
3000 of Andrew Anderson	110	0800	
4000 of Andrew Anderson	110	0800	

SECTION _____

Please indicate well location X.

ADDITIONAL INFORMATION

150 180 190
 120 130 140
 150 160 170
 180 190 200
 210 220 230
 240 250 260
 270 280 290
 300 310 320
 330 340 350
 360 370 380
 390 400 410
 420 430 440
 450 460 470
 480 490 500

If more than one screen, show location of each on sketch.