

N
9-30-61

WATER WELL DRILLERS LOG

(?) N?

Date: 9-30, 1961, Driller: J B Cain County Panola

(Name)

(1) Owner of Land:	Description & Color of Materials Sand, Clay, Red Clay, Shell, etc.	Thick- ness Feet	Depth Feet
<u>Hugh Clayton</u> (Name)	<u>Red soil</u>	<u>0</u>	<u>10</u>
<u>Sardis Miss</u> (Address)	<u>Land</u>	<u>10</u>	<u>115</u>
(2) Location: <u>1/4</u> , <u>1/4</u> , Sec. <u> </u> T. <u> </u> R. <u> </u>	<u>Shrub</u>	<u>45</u>	<u>80</u>
<u>3</u> miles <u>West of Sardis Dam</u> of <u>Sardis</u>	<u>Blue cl</u>	<u>80</u>	<u>112</u>
(distance) (direction) (Nearest Town)	<u>Sand</u>	<u>112</u>	<u>130</u>
(3) Topography: <input checked="" type="checkbox"/> (Hilly) <input type="checkbox"/> (Flat) <input type="checkbox"/> (Level)			
(4) Purpose of Well: <u>for house</u> (Domestic Irrigation Municipal, Industrial, Other)			


Information upon completion of well:

- (1) Diameter 4 1/2 inches.
- (2) Total Depth 130 feet.
- (3) Water Level 80 feet below top of ground.
- (4) Cased to 130, Size 2 in
- (5) Screen: Size 1 1/4, Length 6 FT
- (6) Were any formations sealed against pollution?
 yes, no.

If YES depth of formation _____

Why _____

Drillers Remarks: None

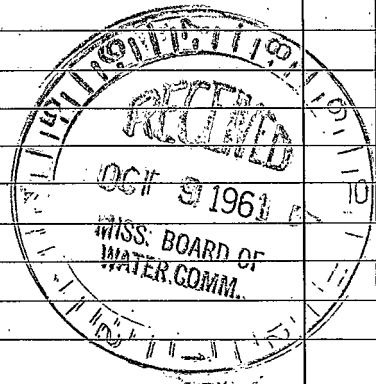

(Use Back Side)

Well No.

