

PANOLA

WATER WELL DRILLERS LOG

N  
4-23-62

Date: 4-23-62, 1962, Driller: H+H Well Co

Panola  
County

(Name)

| (1) Owner of Land  | Description & Color of Materials<br>Sand, Clay, Red Clay, Shell, etc. | Thick-<br>ness<br>Feet | Depth<br>Feet |
|--|---|------------------------|---------------|
| Taylor McClellan<br>(Name)<br>RFD Sardin<br>(Address)                              | 19' Red Clay<br>streak sand   | 19                     | 185           |
| (2) Location: 15 SE. Commo Mt<br>1/4, 1/4, Sec. T R                                | streak clay   | 126                    |               |
| _____ miles _____, of _____<br>(distance) (direction) (Nearest Town)               |   |                        |               |
| (3) Topography: _____<br>(Hilly) (Flat) (Level)                                    |   |                        |               |
| (4) Purpose of Well: Home<br>(Domestic Irrigation<br>Municipal, Industrial, Other) |   |                        |               |


Information upon completion of well:

- (1) Diameter: 2" inches.
- (2) Total Depth: 145' feet.
- (3) Water Level: 130 feet below top of ground.
- (4) Cased to: 139, Size: 2
- (5) Screen: Size: 1 1/4, Length: 6' SS
- (6) Were any formations sealed against pollution?  
\_\_\_\_\_ yes, \_\_\_\_\_ no.

If YES depth of formation \_\_\_\_\_  
Why \_\_\_\_\_

Drillers Remarks: \_\_\_\_\_  
\_\_\_\_\_  
\_\_\_\_\_

Red Pump

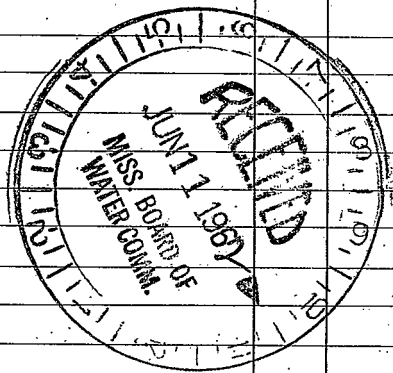

2

Well No.

(Use Back Side)

Retain this copy for your office files.

