

PAIOLA MISSISSIPPI BOARD OF WATER COMMISSIONERS

N

4-22-65

WATER WELL DRILLERS LOG

Date: 4-22, 1965, Driller: J B Cairns County Panola

(Name)

(1) Owner of Land: Charley King
Sardis Miss
(Name)
(Address)

Description & Color of Materials
Sand, Clay, Red Clay, Shell, etc.

Thick-
ness
Feet

Depth
Feet

Bro of
Granite
Sand +

0 30
30 80
80 120

(2) Location: 1/4, 1/4, Sec. T R
E miles S-E SARDIS
(distance) (direction) (Nearest Town)

(3) Topography: (Hilly) (Flat) (Level)

(4) Purpose of Well: Home
(Domestic Irrigation
Municipal, Industrial, Other)

Information upon completion of well:

(1) Diameter 2 inches.

(2) Total Depth 120 feet.

(3) Water Level 80 feet below top of ground.

(4) Cased to 120, Size 2"


(5) Screen: Size 3 Length 5
Granite Screen

(6) Were any formations sealed against pollution?
yes, no.

If YES depth of formation

Why

Drillers Remarks:

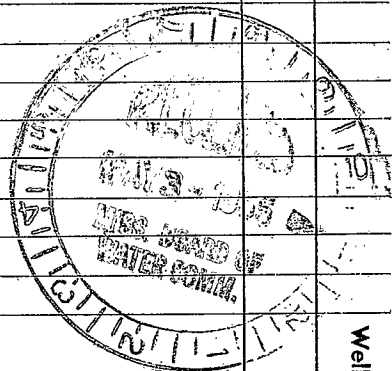

Well No.

(Use Back Side)

