

CODED

MISSISSIPPI
BOARD OF WATER COMMISSIONERS
416 North State Street
Jackson, Mississippi 39201

CODED

WATER WELL DRILLERS LOG

Parola
N 4
9-27-68

Sept 27 19 68 Palmer Water Well Drilling Parola
date well completed firm name county well located

LANDOWNER: W.B. Wright
Batesville, Miss
(mailing address)

description of formations encountered	from	to
	<u>good sand + clay</u>	<u>0</u>
<u>white clay</u>	<u>20</u>	<u>60</u>
<u>sand</u>		

WELL LOCATION:
sec. 11 T. 6 N. R. 6 E.
8 miles NE of Batesville
(distance) (direction) (nearest town)

CODED

WELL PURPOSE: home
(home, irrigation, municipal, industrial)

- WELL COMPLETION DATA:
- (1) diameter (inches) 4"
 - (2) total depth (feet) 60
 - (3) static water level (feet) 8 below above top of ground.
 - (4) casing Plastic, 55
(material) (depth)
4"
(size) If telescope see back.
 - (5) screen 5 ft, 55
(length) (depth to top)
4, gravel packed
(size) (material)
 - (6) pump 3/4, 20
(HP) (yield gpm)
220
(type power)
 - (7) electric log yes
(yes or no)
(organization running log)
 - (8) how well bottom plugged Plugged

CODED


SEP 30 1968

MISS. Bd. of WATER COMMISSIONERS

DRILLERS REMARKS: Plastic water well

If well telescopes please sketch and show depths.

GROUND LEVEL

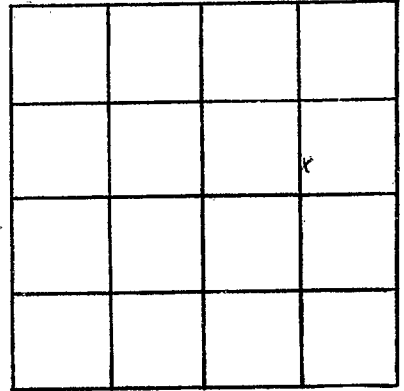

SECTION 11

Please indicate well location X.

ADDITIONAL INFORMATION

If more than one screen, show locations of each on sketch.