

PANOLA

MISSISSIPPI BOARD OF WATER COMMISSIONERS

WATER WELL DRILLERS LOG

CODED

6 NB

11-13-62

Date: 11-13, 1962, Driller: James R. Lips County: Panola

(Name)

(1) Owner of Land: Walter Poyam
(Name)
Sardis
(Address)

(2) Location: 1/4, 1/4, Sec. 12 T8 S
6 miles South of Sardis
(distance) (direction) (Nearest Town)

(3) Topography: Hilly
(Hilly) (Flat) (Level)

(4) Purpose of Well: Domestic
(Domestic Irrigation
Municipal, Industrial, Other)

Description & Color of Materials Sand, Clay, Red Clay, Shell, etc.	Thick- ness Feet	Depth Feet
<u>Clay + Sand</u>	<u>0</u>	<u>50</u>
<u>Sand</u>	<u>50</u>	<u>80</u>
<u>gravel</u>	<u>80</u>	<u>100</u>
<u>Artesian Sand</u>	<u>100</u>	<u>136</u>

Information upon completion of well:

(1) Diameter 2 1/2 inches.

(2) Total Depth 136 feet.

(3) Water Level 80 feet below top of ground.

(4) Cased to 128, Size 2 1/2.

(5) Screen: Size 1 1/2, Length 6'.


(6) Were any formations sealed against pollution?
_____ yes, _____ no.

If YES depth of formation _____

Why _____

Drillers Remarks: _____

CODED

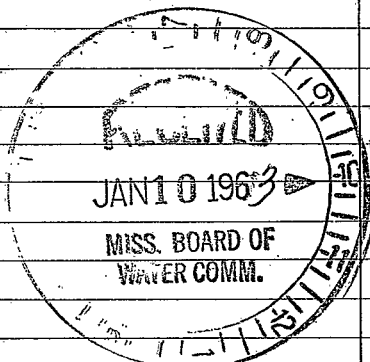

(Use Back Side)

Well No.

