

PANOLA

MISSISSIPPI BOARD OF WATER COMMISSIONERS

R N 10
5-4-65

WATER WELL DRILLERS LOG

CODED

Date: 5 4, 1965, Driller: ^{2 1/2 ft} Frank ~~Byrd~~ ^{Byrd} County, Panola
(Name)

(1) Owner of Land: ward law
(Name)
Batesville Miss.
(Address)

(2) Location: 1/4, 1/4, Sec. 21 T 8 R 6 S W
4 miles N. east of Batesville
(distance) (direction) (Nearest Town)

(3) Topography: Hilly
(Hilly) (Flat) (Level)

(4) Purpose of Well: DOMESTIC
(Domestic Irrigation
Municipal, Industrial, Other)

Description & Color of Materials Sand, Clay, Red Clay, Shell, etc.	Thick-ness Feet	Depth Feet
Top soil	0	20
Red sand	20	40
Gravel and sand	40	60
Black Clay	60	80
" "	80	100
" "	100	125
Water sand	125	140

Information upon completion of well:

(1) Diameter 4 inches.

(2) Total Depth 140 feet.

(3) Water Level 80 feet below top of ground.

(4) Cased to _____, Size _____

(5) Screen: Size 4, Length 6


(6) Were any formations sealed against pollution?
_____ yes, _____ no.

CODED

If YES depth of formation _____

Why _____

Drillers Remarks: _____

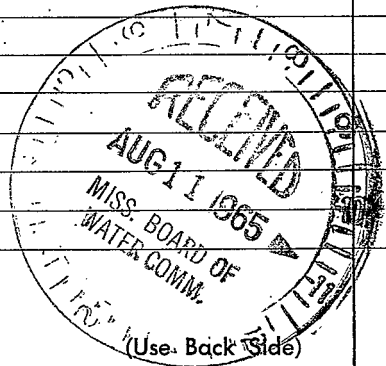

Well No.

Blomby

2 # 2

Batesville Miss.
W.B. Brown

Domestic
Hills

#

↓

#