

PANOLA
R. N. 11

WATER WELL DRILLERS LOG

CODED

Date: 11-5-65, 19

Driller:

Jacqueline Lipe
Mark Doyle

CODED

Panola

11-5-65

(Name)

(1) Owner of Land: W. J. Good

(Name)

Batesville

(Address)

(2) Location: 1/4, 1/4, Sec 25 T8 R6 S W

9 miles east of Batesville (Nearest Town)

(3) Topography: Hilly

(Hilly)

(Flat)

(Level)

(4) Purpose of Well: Domestic

(Domestic Irrigation, Municipal, Industrial, Other)

Description & Color of Materials
Sand, Clay, Red Clay, Shell, etc.

Thick-
ness
Feet

Depth
Feet

Clay	0	50
Sand & gravel	50	90
Shale	90	110
Sand & gravel	110	120
Sand	120	180
Upward	180	221

Information upon completion of well:

(1) Diameter 4 inches.

(2) Total Depth 221 feet.

(3) Water Level 1.40 feet below top of ground.

(4) Cased to 217, Size 4"

(5) Screen: Size 4", Length 4"

(6) Were any formations sealed against pollution?


yes, no.

If YES depth of formation

Why

Drillers Remarks:

CODED

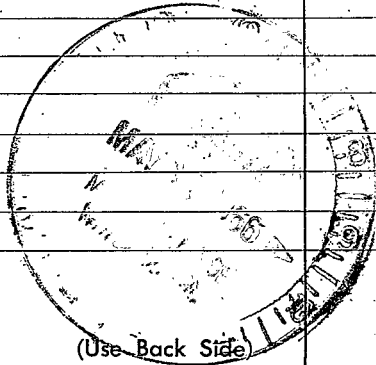

(Use Back Side)

Well No.

1912

1913

1914