

Panola
 N12
 2-5-70

MISSISSIPPI
 BOARD OF WATER COMMISSIONERS
 416 North State Street
 Jackson, Mississippi 39201

CODED

WATER WELL DRILLERS LOG

2-5 1970 TO PIPE WELL CO PANOLA
 date well completed firm name county well located

LANDOWNER:
 James Wilson, Jr
 Blackjack, Miss
 (mailing address)

WELL LOCATION:
 sec. 30 T. 8 R. 6 E
 10 miles NE of Batesville
 (distance) (direction) (nearest town)

WELL PURPOSE: home
 (home, irrigation, municipal, industrial)

WELL COMPLETION DATA:
 (1) diameter (inches) 4"
 (2) total depth (feet) 240
 (3) static water level (feet) 80' below above top of ground.
 (4) casing PVC 232' (material) (depth)
 4" if telescope see back. (size)
 (5) screen 8' 232' (length) (depth to top)
 4" PVC + silica (size) (material)
 (6) pump 3/4 10 (HP) (yield gpm)
 elec (type power)
 (7) electric log no (yes or no)
 (organization running log)
 (8) how well bottom plugged PVC cap

description of formations encountered	from	to
top soil + clay	0	20
clay	20	40
clay	40	60
clay	60	80
clay	80	100
sand	100	120
sand	120	140
clay	140	160
clay	160	180
sand	180	200
sand	200	220
sand	220	240

CODED


MAR 5 - 1970

MISS. Bd. of WATER COMM.

DRILLERS REMARKS:
 rock 86' - 162'

If well telescopes please sketch and show depths.

GROUND LEVEL

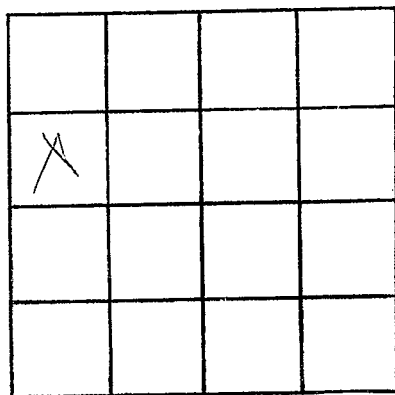

SECTION 212

Please indicate well location X.

ADDITIONAL INFORMATION

If more than one screen, show locations of each on sketch.