

Panola
N 16
6-16-70

MISSISSIPPI
 BOARD OF WATER COMMISSIONERS
 416 North State Street
 Jackson, Mississippi 39201

CODED

WATER WELL DRILLERS LOG

6.16 1970 JAMES R. LIPE Panola
 date well completed firm name county well located

LANDOWNER: Bethlehem Church

description of formations encountered	from	to
<u>Clay</u>	<u>0</u>	<u>20</u>
<u>"</u>	<u>20</u>	<u>40</u>
<u>"</u>	<u>40</u>	<u>60</u>
<u>Sand</u>	<u>60</u>	<u>84</u>

Batesville Miss.
 (mailing address)

WELL LOCATION:

sec. 33 T 8 N R 6 E
6 miles east of Batesville
 (distance) (direction) (nearest town)

WELL PURPOSE: Church
 (home, irrigation, municipal, industrial)

WELL COMPLETION DATA:

- (1) diameter (inches) 2
- (2) total depth (feet) 84
- (3) static water level (feet) 20 below top of ground.
- (4) casing P.V. 28
 (material) (depth)
2 if telescope see back.
 (size)
- (5) screen 6 28
 (length) (depth to top)
1/4" S.S.
 (size) (material)
- (6) pump red 3
 (HP) (yield gpm)
elec.
 (type power)
- (7) electric log no
 (yes or no)
no
 (organization running log)
- (8) how well bottom plugged with point

CODED


JUL 10 1970

MISS. DE. OF
 WATER COMMISSIONERS

DRILLERS REMARKS:

If well telescopes please sketch and show depths.

GROUND LEVEL

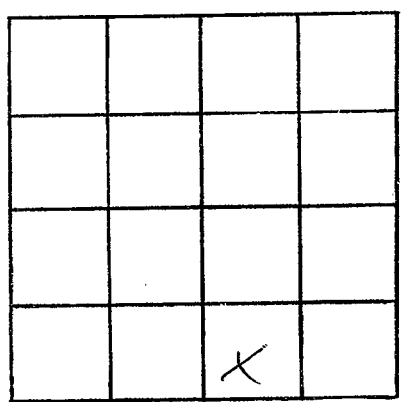

SECTION 33

Please indicate well location X.

ADDITIONAL INFORMATION

If more than one screen, show locations of each on sketch.