

PANOLA

N18

10-30-70

MISSISSIPPI
 BOARD OF WATER COMMISSIONERS
 416 North State Street
 Jackson, Mississippi 39201

CODED

WATER WELL DRILLERS LOG

10/30/70 C. B. PERRY

PANOLA

date well completed

firm name

county well located

LANDOWNER: BILL GRAHAM

3620 GOWAN, SR

MEMPHIS TENN
(mailing address)

WELL LOCATION:

sec. 8 T. 8 N. R. 6 E. W. 6
 1 1/2 miles E of SARDIS
 (distance) (direction) (nearest town)
 WEEKEND

WELL PURPOSE: CABIN
(home, irrigation, municipal, industrial)

WELL COMPLETION DATA:

- (1) diameter (inches) 2 1/2"
- (2) total depth (feet) 118'
- (3) static water level (feet) 6' below above top of ground.
- (4) casing STEEL 102'
(material) (depth)
2" if telescope see back.
(size)
- (5) screen 6' 102'?
(length) (depth to top)
1/4" STAINLESS STEEL
(size) (material)
- (6) pump 3 4
(HP) (yield gpm)
ELECT
(type power)
- (7) electric log no
(yes or no)

(organization running log)

(8) how well bottom plugged STEEL

DRILLERS REMARKS:

description of formations encountered

from

to

CLAY	0	6
SAND	6	25
COMBO (MUD)	25	75
SAND	75	85
SHALE	85	108
FINE SAND	108	118


CODED

NOV 30 1970

MISS. BD OF WATER COMM.

If well telescopes please sketch and show depths.

GROUND LEVEL

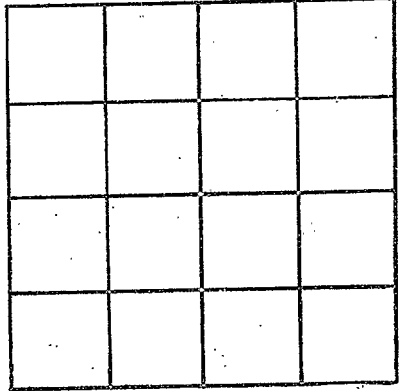

SECTION _____

Please indicate well location X.

ADDITIONAL INFORMATION

If more than one screen,
show locations of each on sketch.