

PANOLA

N 19

10-16-70

MISSISSIPPI
 BOARD OF WATER COMMISSIONERS
 416 North State Street
 Jackson, Mississippi 39201

CODED

WATER WELL DRILLERS LOG

10-16

1970 James A. Lipe

Panola

date well completed

firm name

county well located

LANDOWNER: Stanford

draper

description of formations encountered

from

to

Batesville Miss.

(mailing address)

Clay

0 20

Sand

20 40

ll

40 60

ll

60 70

rock

70 80

Sand

80 107

WELL LOCATION:

sec. 20 T. 8 N. R. 6 E.
 3 miles East of Batesville
 (distance) (direction) (nearest town)

WELL PURPOSE: HOME
 (home, irrigation, municipal, industrial)

WELL COMPLETION DATA:

- (1) diameter (inches) 4
- (2) total depth (feet) 107
- (3) static water level (feet) 50 below top of ground.
- (4) casing pvc 97
 (material) (depth)
 (size) if telescope see back.
- (5) screen 10 97
 (length) (depth to top)
4 pvc
 (size) (material)
- (6) pump 3/4 10
 (HP) (yield gpm)
Elec
 (type power)
- (7) electric log no
 (yes or no)

CODED

(organization running log)


DEC 3 1970

MISS. BD. OF
WATER COMM.

(8) how well bottom plugged pvc
plug
 DRILLERS REMARKS: Cut 10'
Rock

If well telescopes please sketch and show depths.

GROUND LEVEL

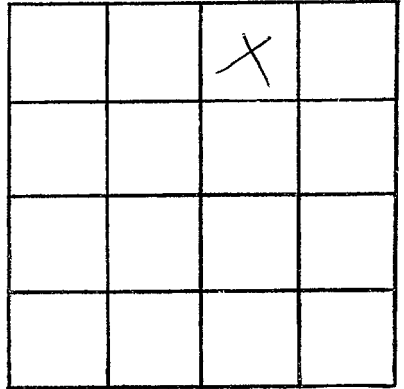

SECTION 20

Please indicate well location X.

ADDITIONAL INFORMATION

If more than one screen, show locations of each on sketch.