

MISSISSIPPI
BOARD OF WATER COMMISSIONERS
416 North State Street
Jackson, Mississippi 39201

WATER WELL DRILLERS LOG

CODED

PANOLA
N22
11-23-71

11-23-71 19 JIM-REARLY PANOLA
date well completed firm name county well located

LANDOWNER: <u>HORACE - BALLENTINE</u> <u>RT-1</u>	description of formations encountered	from	to
<u>SARDIS, Miss</u> (mailing address)	<u>DIRT</u> <u>SAND + GRAVEL</u> <u>SAND</u>	<u>0</u> <u>10</u> <u>50</u>	<u>10</u> <u>50</u> <u>65</u>
WELL LOCATION: sec. <u>28</u> T. <u>8</u> N. R. <u>6</u> E. S. W. <u>6</u> miles <u>SE</u> of <u>SARDIS</u> (distance) (direction) (nearest town)			
WELL PURPOSE: <u>HOME</u> (home, irrigation, municipal, industrial)			
WELL COMPLETION DATA:			
(1) diameter (inches) <u>2" + 1/4"</u>			
(2) total depth (feet) <u>85</u>			
(3) static water level (feet) <u>50</u> below above ground.			
(4) casing <u> GALV</u> <u>61'</u> (material) (depth)			
<u>2 1/2" M^H</u> if telescope see back. (size)			
(5) screen <u>48"</u> <u>61</u> (length) (depth to top)			
<u>1 1/4"</u> <u>5" FRASSIS-STEEL</u> (size) (material)			
(6) pump <u>3/4</u> <u>4</u> (HP) (yield gpm)			
<u>ELC</u> (type power)			
(7) electric log <u>NO</u> (yes or no)			
(organization running log)			
(8) how well bottom plugged <u>D.P.E.V.</u>			
DRILLERS REMARKS:			

CODED



JAN 26 1972

MISS. BD.
WATER

If well telescopes please sketch and show depths.

GROUND LEVEL

2 IN. 5-7'

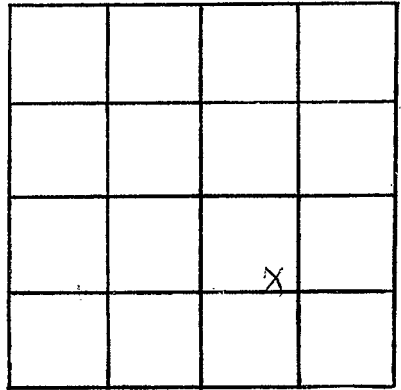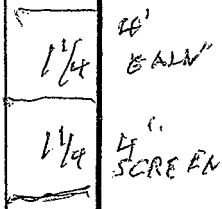

SECTION 28

Please indicate well location X.

ADDITIONAL INFORMATION

If more than one screen, show locations of each on sketch.