

Panola
N 24
1-67

MISSISSIPPI
BOARD OF WATER COMMISSIONERS
416 North State Street
Jackson, Mississippi 39201

CODED

WATER WELL DRILLERS LOG

1-3-1967 Robertson, Son Panola
date well completed firm name county well located

LANDOWNER: O.B. Henderson

description of formations encountered

from to

Batesville, Miss
(mailing address)

Land + Clay	0	20
Gravel + Sand	20	40
Clay	40	60
Blue Clay	60	100
Blue Clay + sand	100	120
Sand	120	160

WELL LOCATION:

sec. 25-T 8 N R 6 E
S W
8 miles NE of Batesville
(distance) (direction) (nearest town)

WELL PURPOSE: Home
(home, irrigation, municipal, industrial)

WELL COMPLETION DATA:

- diameter (inches) 4 in
- total depth (feet) 160 ft
- static water level (feet) 85 ft below top of ground.
- casing Plastic, 15.5'
(material) (depth)
4 in if telescope see back.
(size)
- screen 5 ft, 15.5 ft
(length) (depth to top)
6 in, gravel packed
(size) (material)
- pump 1/2 18
(HP) (yield gpm)
T.V.A. 220
(type power)

CODED

(7) electric log NO
(yes or no)

(organization running log)


(8) how well bottom plugged Wash bottom

DRILLERS REMARKS: Plastic Water Well



If well telescopes please sketch and show depths.

GROUND LEVEL

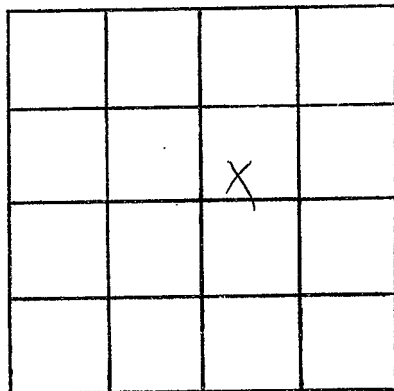

SECTION 25

Please indicate well location X.

ADDITIONAL INFORMATION

If more than one screen, show locations of each on sketch.