

PANOLA
N 26
5-25-73

MISSISSIPPI
BOARD OF WATER COMMISSIONERS
416 North State Street
Jackson, Mississippi 39201

CODED

WATER WELL DRILLERS LOG

5-25-1973 James R. Lipe Panola
date well completed firm name county well located

LANDOWNER:
Barney McLarty
Batesville Miss.
(mailing address)

description of formations encountered	from	to
Red clay	0	20
cc sand	20	40
Black clay	40	60
cc cc	60	80
sand and clay	80	100
white sand	100	132

WELL LOCATION:
sec. 16 T. 8 N R. 6 E
8 miles East of Batesville
(distance) (direction) (nearest town)

WELL PURPOSE:
(home) irrigation, municipal, industrial

- WELL COMPLETION DATA:
- (1) diameter (inches) 4"
 - (2) total depth (feet) 137
 - (3) static water level (feet) 90 below top of ground.
 - (4) casing PVC 129
(material) (depth)
4 if telescope see back.
(size)
 - (5) screen 8 129
(length) (depth to top)
4 PVC
(size) (material)
 - (6) pump 3/4 10
(HP) (yield gpm)
Elec
(type power)
 - (7) electric log no
(yes or no)
no
(organization running log)
 - (8) how well bottom plugged PVC
plug


CODED

JUN 7 1973

DRILLERS REMARKS:

If well telescopes please sketch and show depths.

GROUND LEVEL

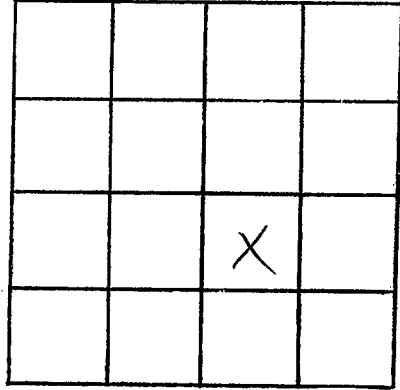

SECTION 16

Please indicate well location X.

ADDITIONAL INFORMATION

A series of horizontal lines for writing additional information.

If more than one screen, show locations of each on sketch.