

PANOLA  
 N 28  
 9-20-73

MISSISSIPPI  
 BOARD OF WATER COMMISSIONERS  
 416 North State Street  
 Jackson, Mississippi 39201

**CODED**

WATER WELL DRILLERS LOG

9-20 date well completed      1973 Lipe Well Co firm name      Panola county well located

LANDOWNER:  
 Jerry Johnson  
 Batesville Miss.  
 (mailing address)

description of formations encountered	from	to
TOP soil	0	20
Clay	20	40
Red sand	40	60
Pea gravel	60	80
sand	80	100
Blue clay	100	120
" "	120	140
" "	140	160
Clay and sand	160	180
sand	180	201

WELL LOCATION:  
 sec. 32 T 8 N R 6 E  
 6 miles E of Batesville  
 (distance) (direction) (nearest town)

WELL PURPOSE:  
 (home) Irrigation, municipal, industrial

- WELL COMPLETION DATA:
- (1) diameter (inches) 4
  - (2) total depth (feet) 201
  - (3) static water level (feet) 60 below top of ground.
  - (4) casing PVC, 186,  
 (material) (depth)  
4 if telescope see back.  
 (size)
  - (5) screen 15, 186  
 (length) (depth to top)  
4, PVC  
 (size) (material)
  - (6) pump 3/4, 10  
 (HP) (yield gpm)  
elec.  
 (type power)
  - (7) electric log NO  
 (yes or no)  
NO  
 (organization running log)
  - (8) how well bottom plugged PVC  
plug


**CODED**

DRILLERS REMARKS:

NET 9 1973

If well telescopes please sketch and show depths.

GROUND LEVEL

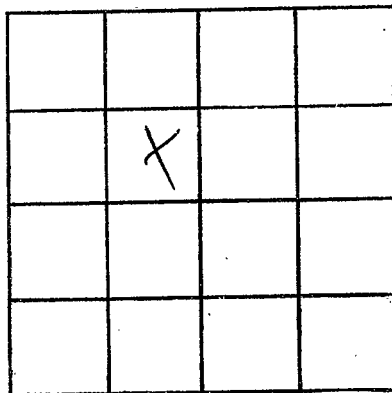

SECTION 32

Please indicate well location X.

ADDITIONAL INFORMATION

If more than one screen,  
show locations of each on sketch.