

PANOLA
N 29
11-3-73

MISSISSIPPI
 BOARD OF WATER COMMISSIONERS
 416 North State Street
 Jackson, Mississippi 39201

CODED

WATER WELL DRILLERS LOG

11-3 date well completed 1973 Life Well Co. firm name Panola county well located

LANDOWNER:
W. C. Woodard
Batesville Miss.
 (mailing address)

description of formations encountered	from to	
	feet	feet
TOP soil	0	20
red sand	20	40
" "	40	60
clay	60	80
" "	80	100
white sand	100	160

WELL LOCATION:
 sec. 24 T. 8 N. R. 6 E.
 (S) (W)
10 miles East of Batesville
 (distance) (direction) (nearest town)

WELL PURPOSE:
 (home) Irrigation, municipal, industrial

- WELL COMPLETION DATA:**
- (1) diameter (inches) 4
 - (2) total depth (feet) 160
 - (3) static water level (feet) 100 below above top of ground.
 - (4) casing PVC 150
 (material) (depth)
4 if telescope see back.
 (size)
 - (5) screen 10 150
 (length) (depth to top)
4 PVC
 (size) (material)
 - (6) pump 3/4 10
 (HP) (yield gpm)
elec.
 (type power)
 - (7) electric log no
 (yes or no)
no
 (organization running log)
 - (8) how well bottom plugged PVC
CAP


CODED

DRILLERS REMARKS:

NOV 10 1973

If well telescopes please sketch and show depths.

GROUND LEVEL

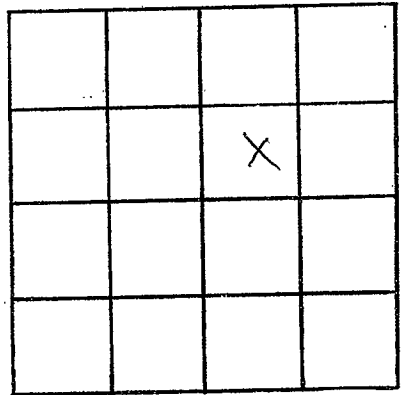

SECTION 24

Please indicate well location X.

ADDITIONAL INFORMATION

If more than one screen, show locations of each on sketch.